


T.13S. R.10W. W.M.

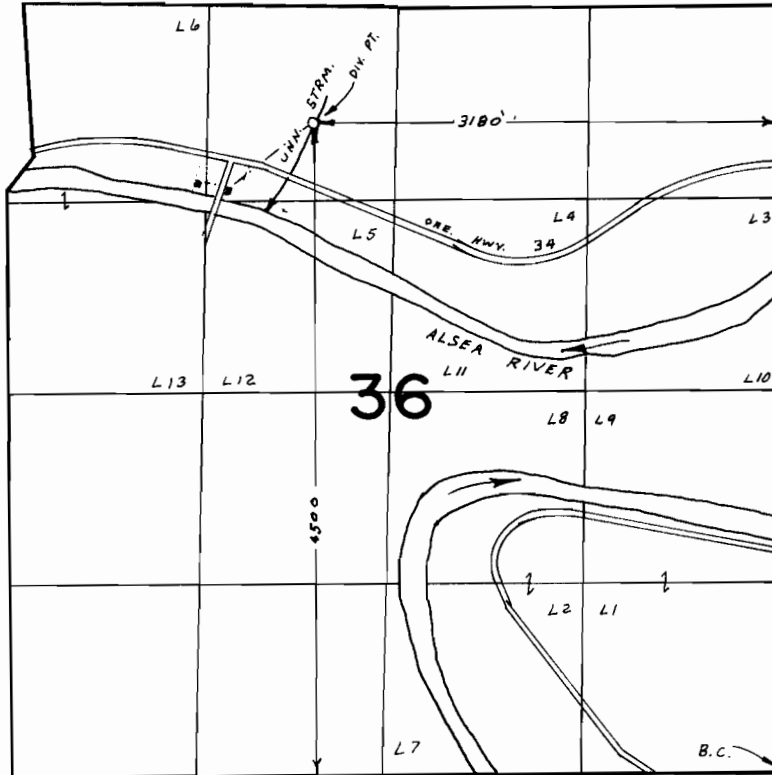

FINAL PROOF SURVEY UNDER

Application No. 42 914 Permit No. 31592
IN NAME OF

IRVIN R. PHIFER

Surveyed JUN 5 1974, by LH NUNN