


T.13S.,R.11W.,W.M.

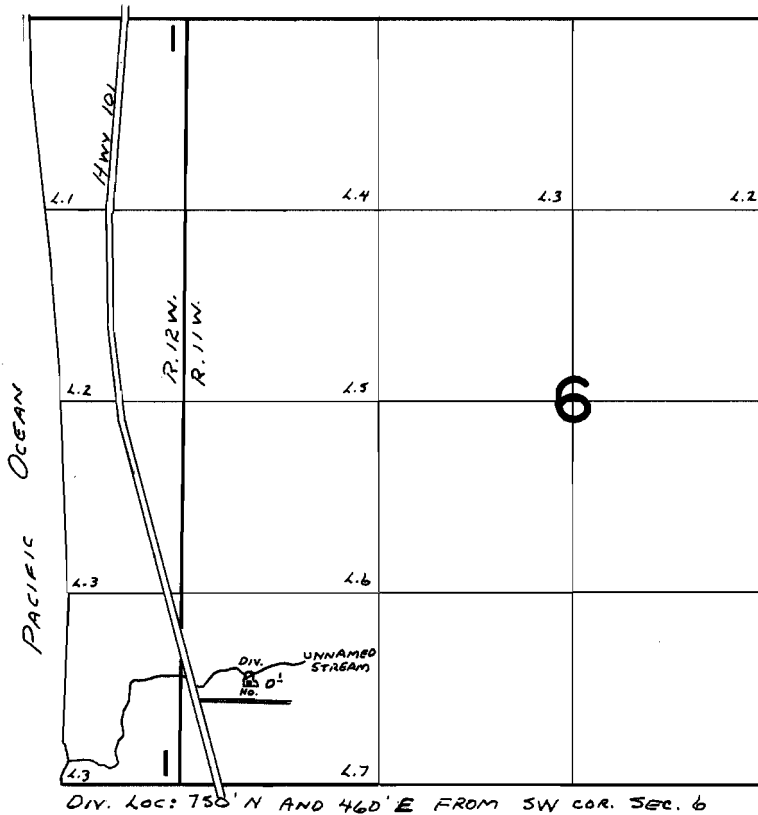

FINAL PROOF SURVEY
UNDER

Application No. 44463 Permit No. 33297
IN NAME OF

CURTIS TERRELL AND MARGARET M. MORSE

Surveyed SEPT. 12 1975, by L. Tell