


T. 6S. R. 10W. W.M.

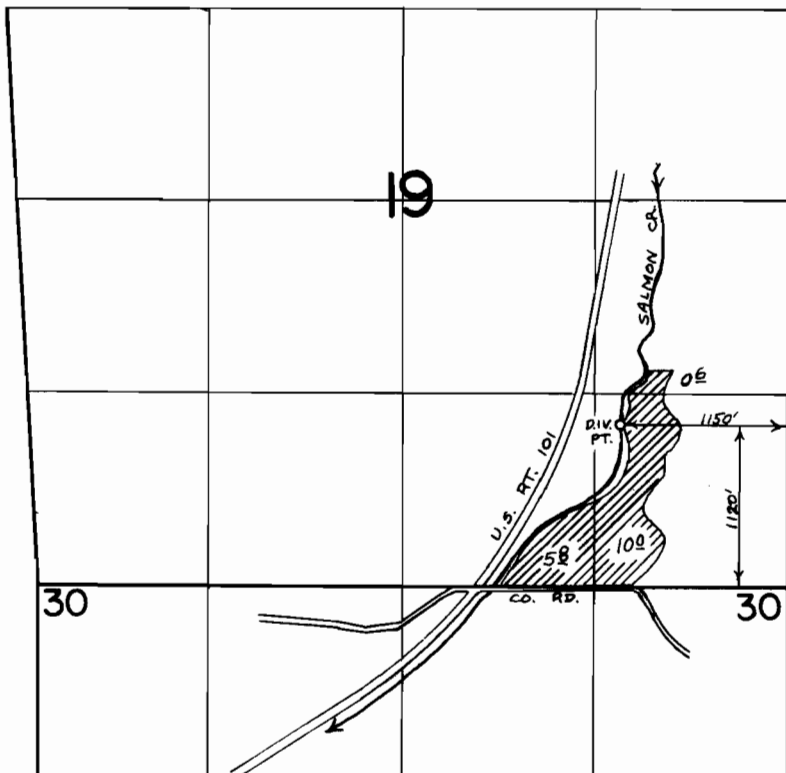

FINAL PROOF SURVEY
UNDER

Application No. 46838 Permit No. 35025
IN NAME OF

THOMAS V. MORGAN & SHARON R. MORGAN

Surveyed JULY 16, 1974, by D. NORBY