


# T. 14S. R. 2W. W.M.

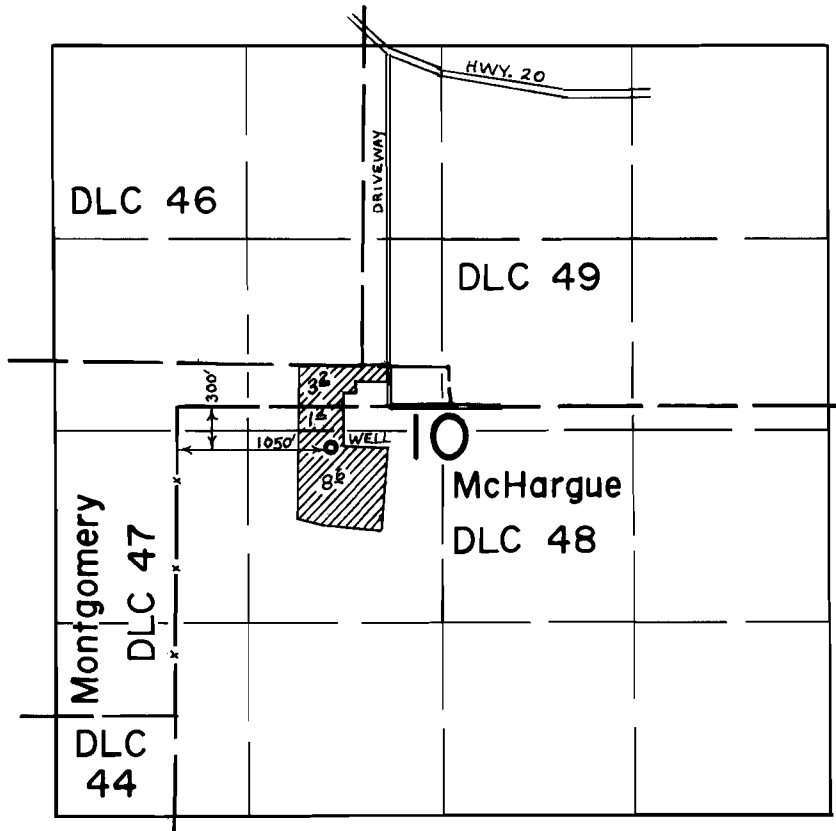

## FINAL PROOF SURVEY UNDER

Application No. G-5245 Permit No. G-5100  
IN NAME OF

J. I. McCORD

Surveyed NOV. 6 1974., by D. NORBY