


T.14S. R.2W. W.M.

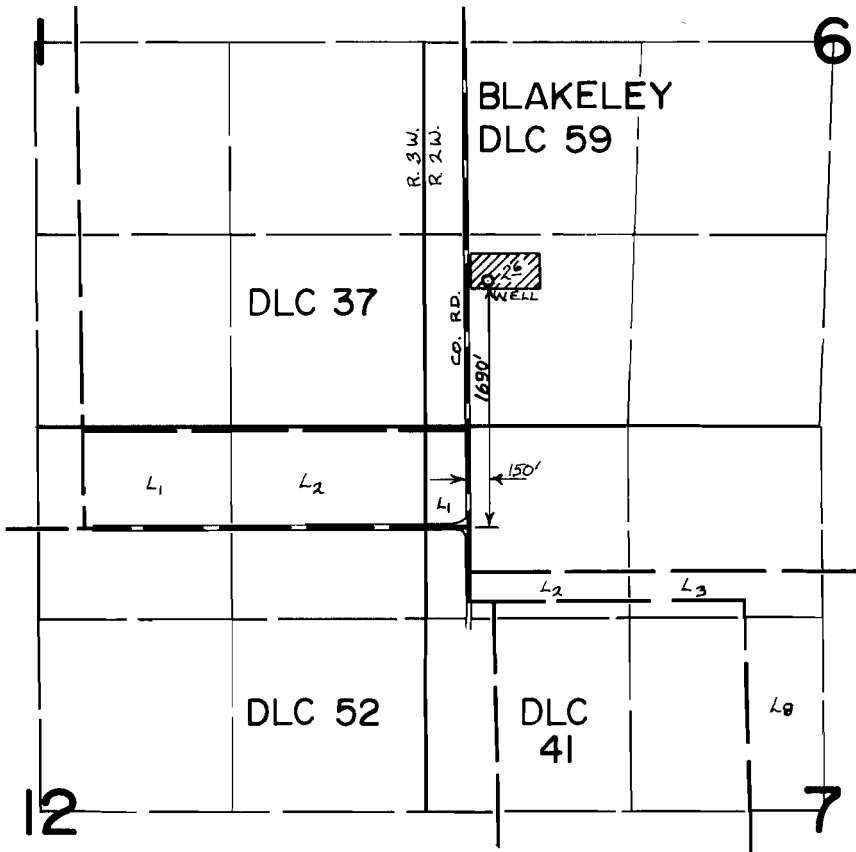

FINAL PROOF SURVEY
UNDER

Application No. G-5323 Permit No. G-5145
IN NAME OF

ANDREW & URSULA KARO

Surveyed AUG. 8 1974, by D. NORBY