


T.9S., R.1W., W.M.

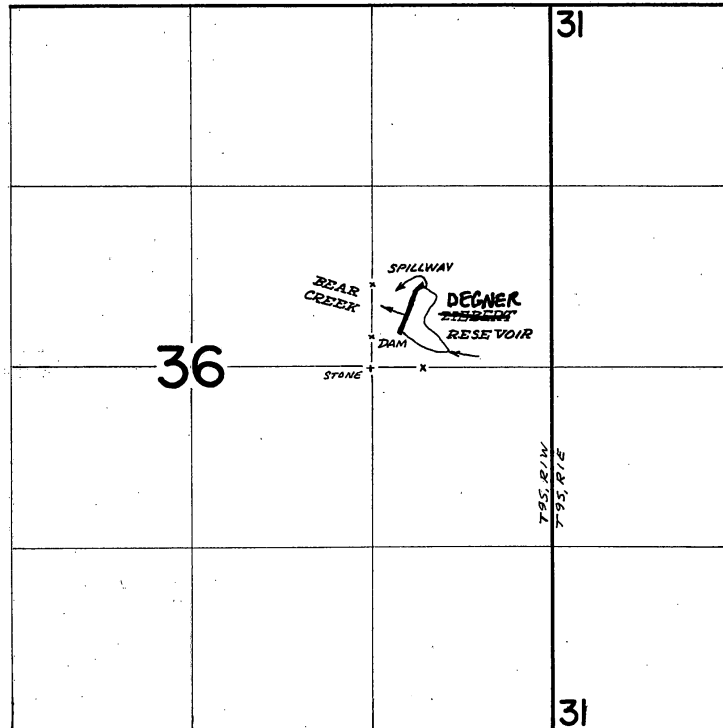

DAM LOCATED: 370' N & 260' E FROM SE COR SE $\frac{1}{4}$ NE $\frac{1}{4}$ SEC 36.

FINAL PROOF SURVEY
UNDER

Application No. R-49455 Permit No. R-5834
IN NAME OF

GEORGE G. DEGNER, MD

Surveyed May 22, 1974, by D. Norby

DC/WRD 2/21/2020

PTS-1974-A