
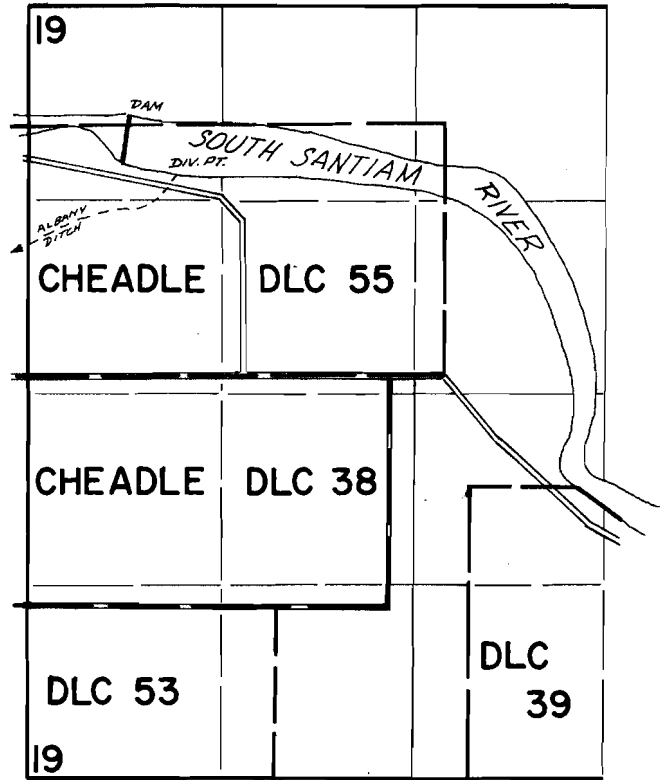


T.11S., R.2W., W.M.

T.12S., R.1W., W.M.

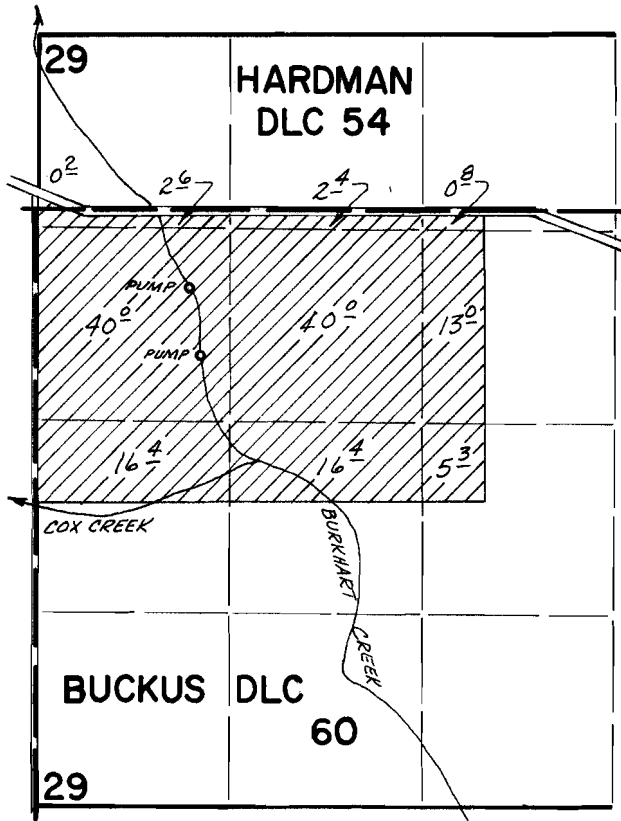

DIV. PT. LOCATED: 1400' N & 1360' W FROM NE COR. CHEADLE DLC 38.

### FINAL PROOF SURVEY UNDER

Application No. 43934 Permit No. 32362  
IN NAME OF

GRAND PRAIRIE WATER CONTROL DISTRICT

Surveyed April 1 1974, by D.M. Norby