


T.13S.,R.3W.,W.M.

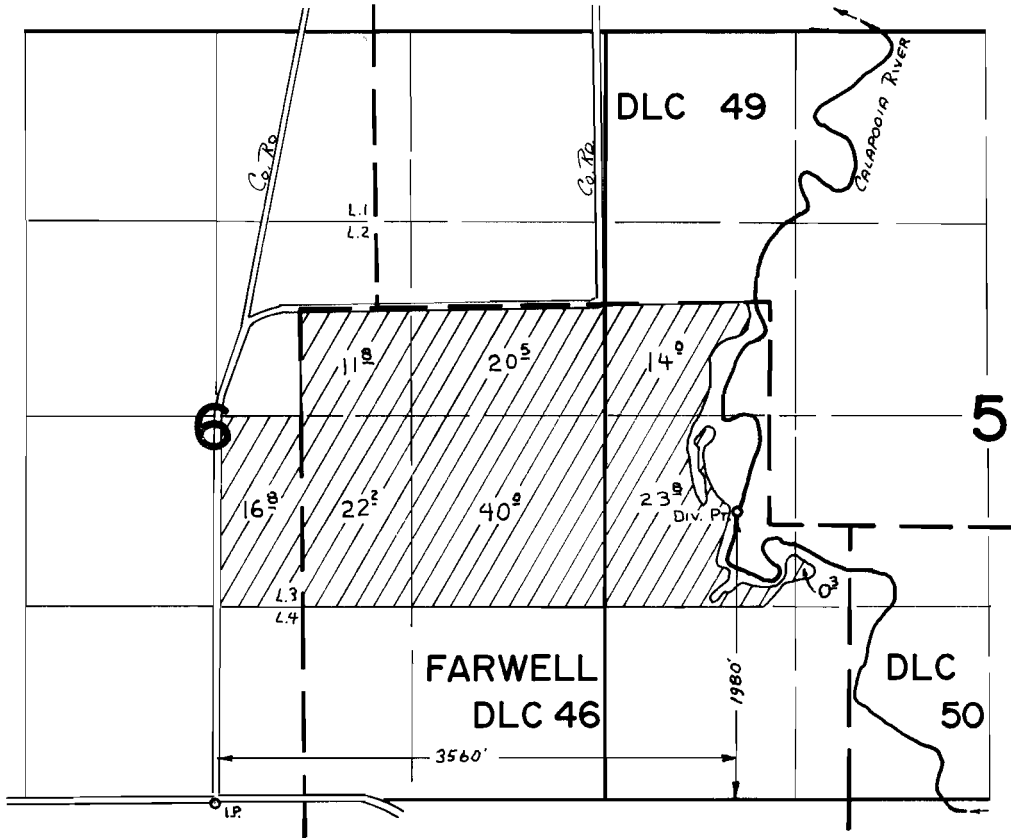

FINAL PROOF SURVEY
UNDER

Application No. 45137 Permit No. 33493
IN NAME OF

WIRTH FARMS

Surveyed Oct. 14 1974, by L. Tott