


T.12S., R.4W., W.M.

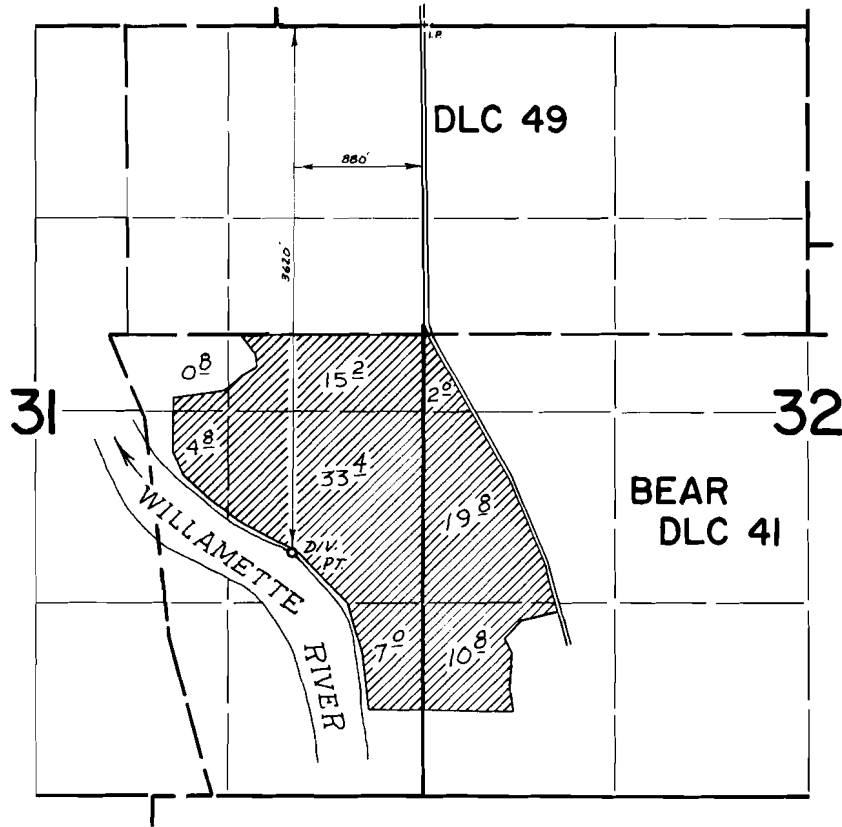

FINAL PROOF SURVEY
UNDER

Application No. 45855 Permit No. 34235
IN NAME OF

HILBERT-SIM FARMS, INC.

Surveyed May 28 1974, by D.M. Norby