T.11S., R.4W., W.M.

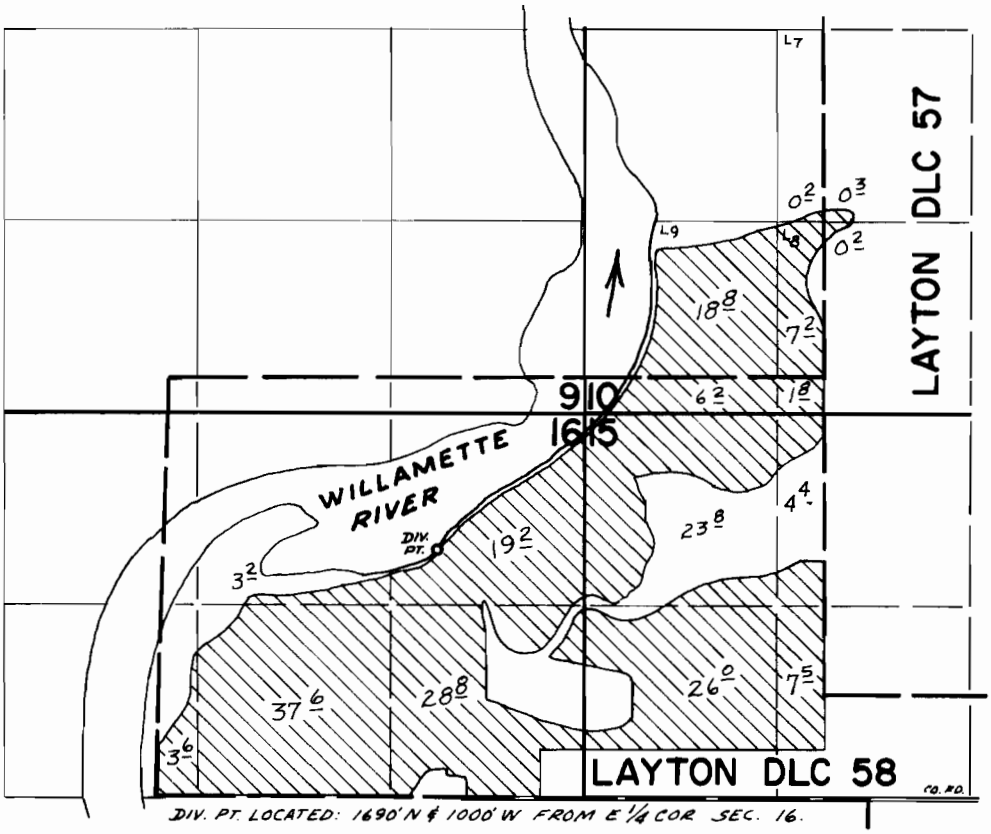

DIV. PT. LOCATED: 1690' N & 1000' W FROM E 1/4 COR SEC. 16.

FINAL PROOF SURVEY
UNDER

Application No. 46047 Permit No. 34387
IN NAME OF

LAUREN M. AND DOROTHY MAE KARSTENS

Surveyed May 29 1974, by D.M. Norby

DFJ-244-149