T. 13S. R. 1E. W.M.

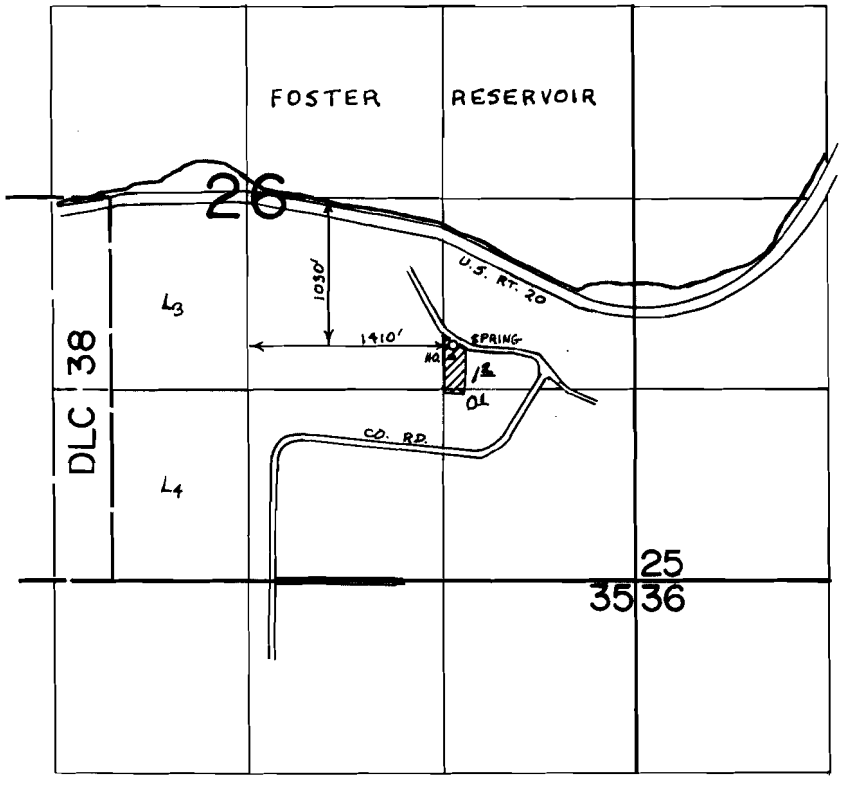

FINAL PROOF SURVEY
UNDER

Application No. 46241 Permit No. 34548
IN NAME OF

FRED O. SANTESSON

Surveyed AUG. 9 1974, by D. NORBY

DFM-4LL-135 Dp