


T.IOS., R.IW.&IE.,W.M.

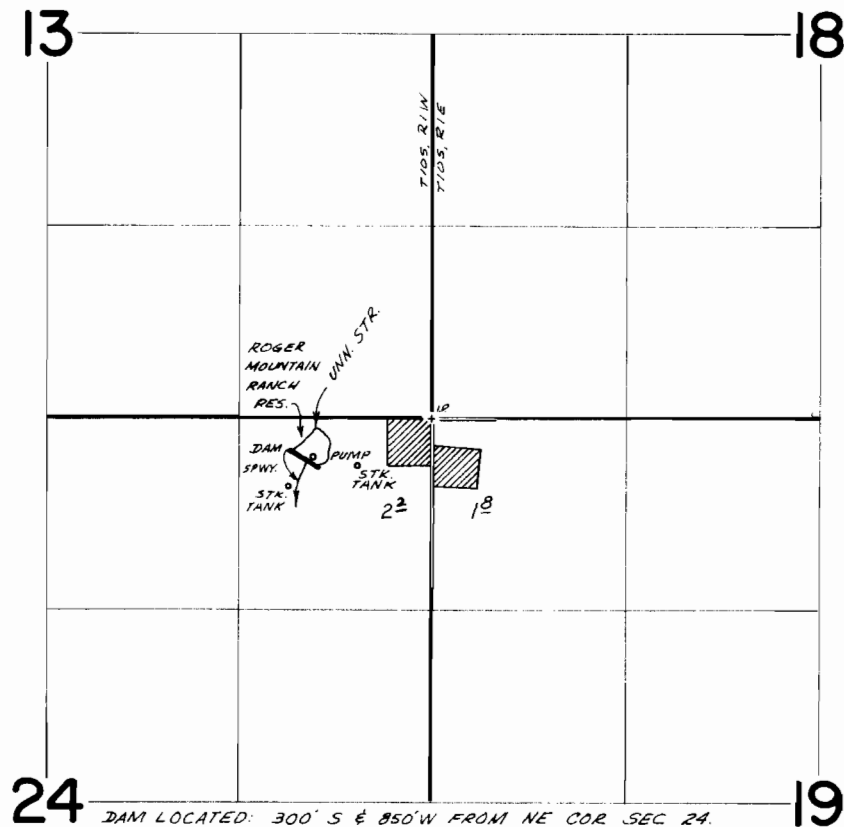

FINAL PROOF SURVEY UNDER

Application No. **R-47105** **47106** Permit No. **R-5596** **34945**
IN NAME OF

H. O. LIVENGOD

Surveyed **May 22** 1974, by **D. Norby**