


T.10S., R.1W.&1E., W.M.

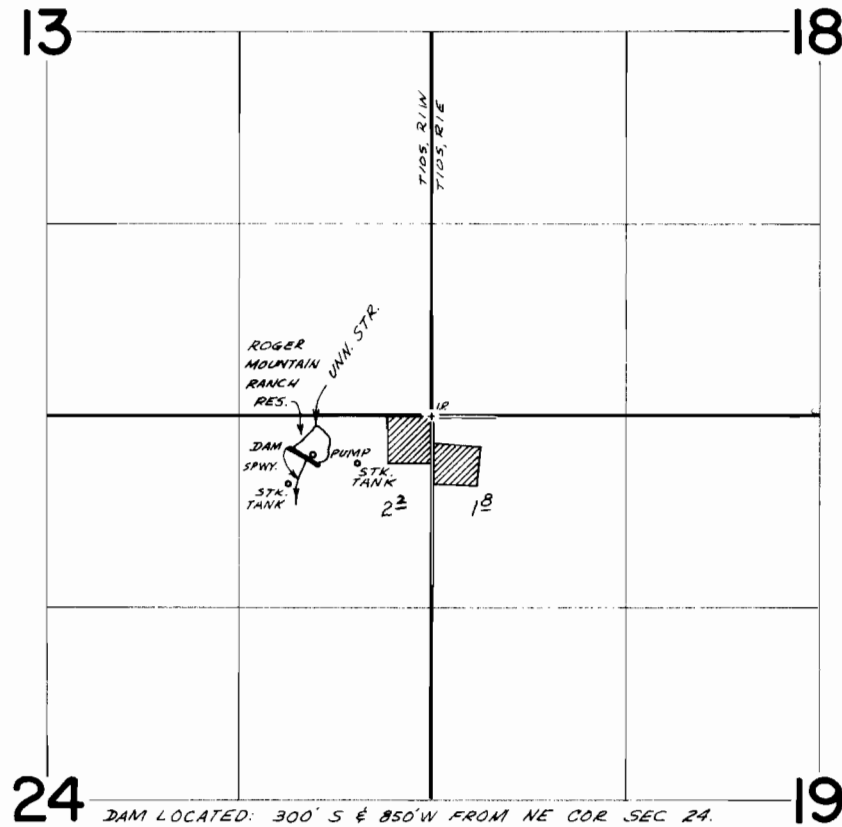

FINAL PROOF SURVEY
UNDER

R-47105 R-5596
Application No. 47106 Permit No. 34945
IN NAME OF

H. O. LIVENGOOD

Surveyed May 22, 1974, by D. Norby