


# T.I.S., R.I.E., W.M.

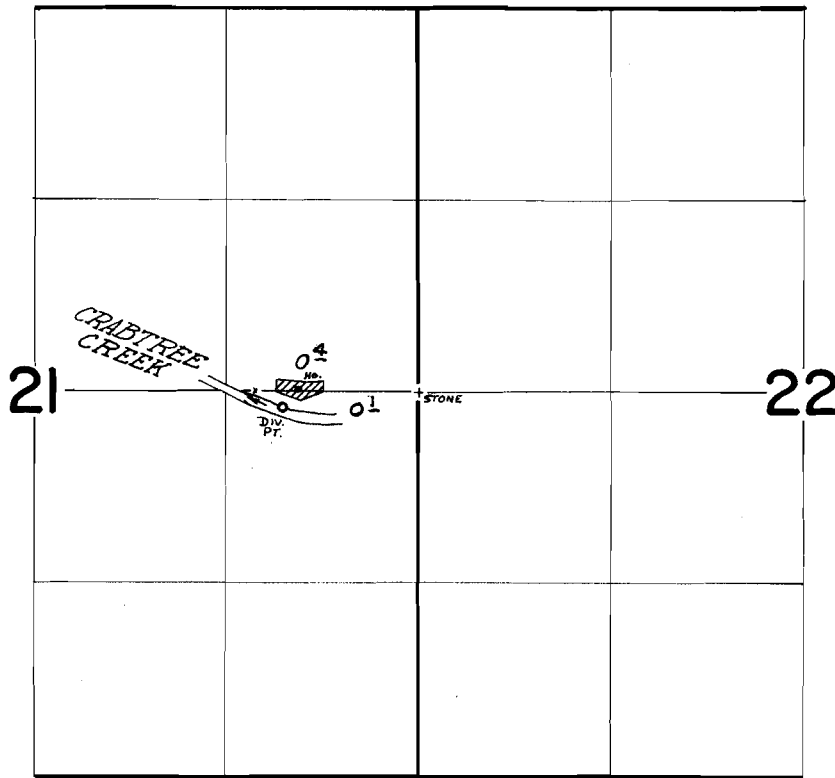

DIV. PT. LOCATED: 110' S & 930' W FROM E  $\frac{1}{4}$  COR. SEC. 21.

## FINAL PROOF SURVEY UNDER

Application No. 48380 Permit No. 36321  
IN NAME OF

CLAUDE R. MOORE

Surveyed May 20 1974, by D.M. Norby