


T.9S., R.2E., W.M.

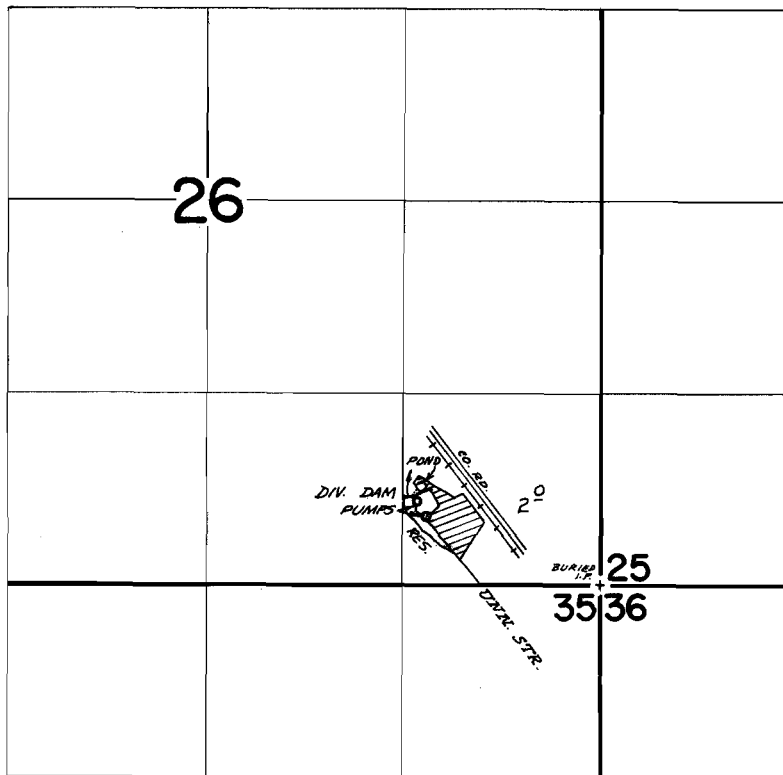

DIV. DAM LOCATED: 620' N & 1330' W FROM SE COR. SEC. 26.

FINAL PROOF SURVEY
UNDER

Application No. 48533 Permit No. 36425
IN NAME OF

DEAN L. AND MILDRED G. JETER

Surveyed April 30 1974, by D. Norby