


T.12S., R.4&5W., W.M.

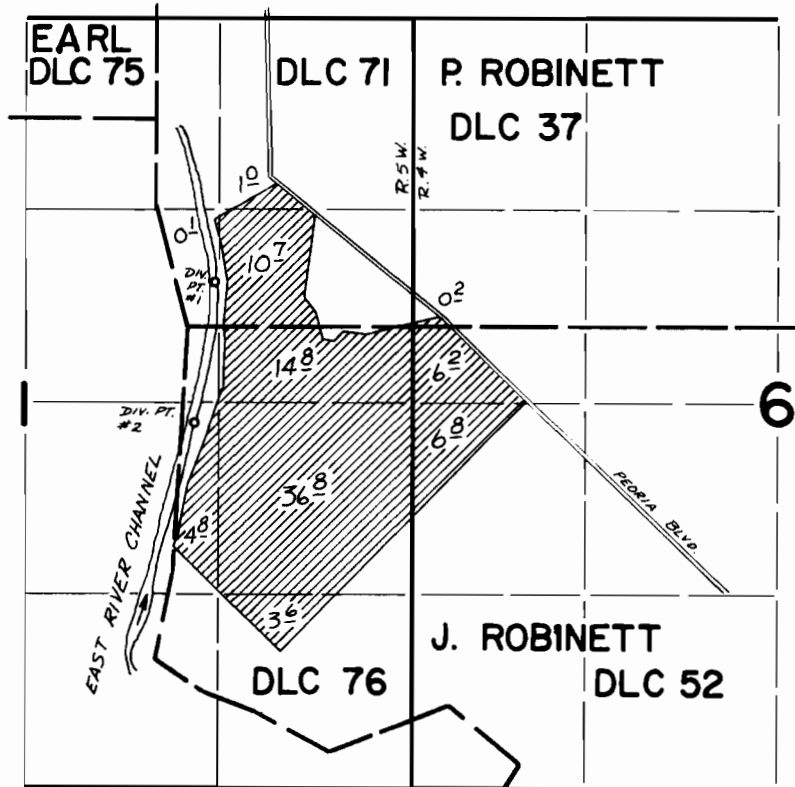

DIV. PTS. LOCATED: 1- 1110'S & 410'E; 2- 2085'S & 280'E FROM SE COR EARL DLC 75.

FINAL PROOF SURVEY
UNDER

Application No. 49368 Permit No. 37007
IN NAME OF
CLARENCE Z. AND DORIS E. SMITH

Surveyed May 1 1974, by D.M.Norby