


T. 13S. R. 2E. W.M.

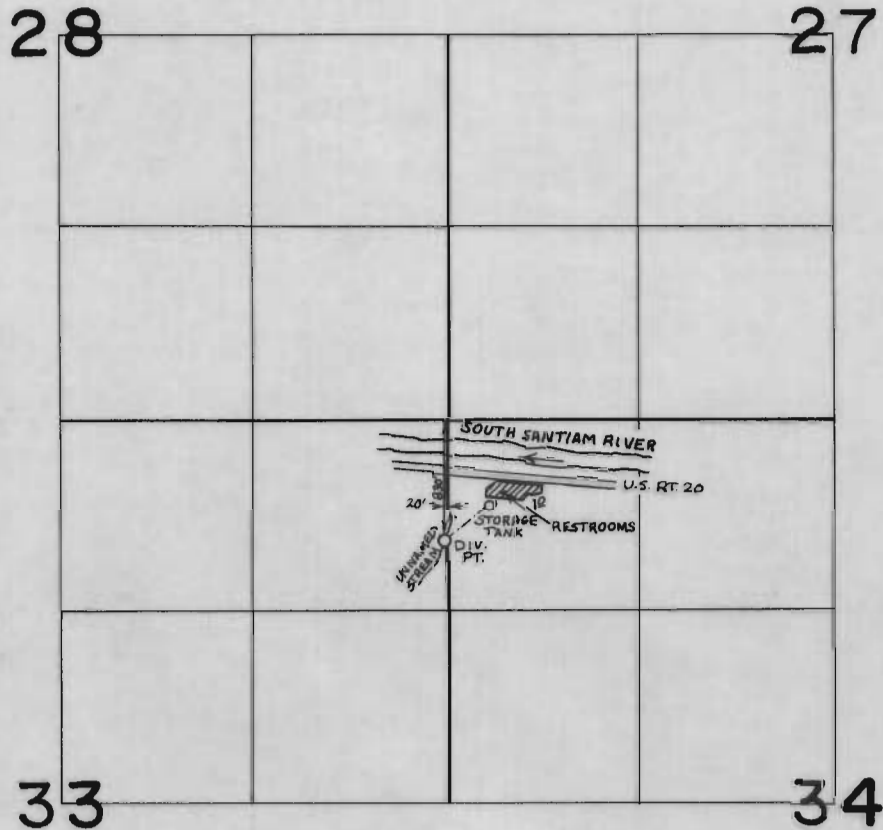

FINAL PROOF SURVEY
UNDER

Application No. 49447 Permit No. 37042
IN NAME OF

WILLIS G. & MAXINE V. RICE

Surveyed OCT. 16 1974, by D. NORBY