


# T.I.S., R.I.W.& I.E., W.M.

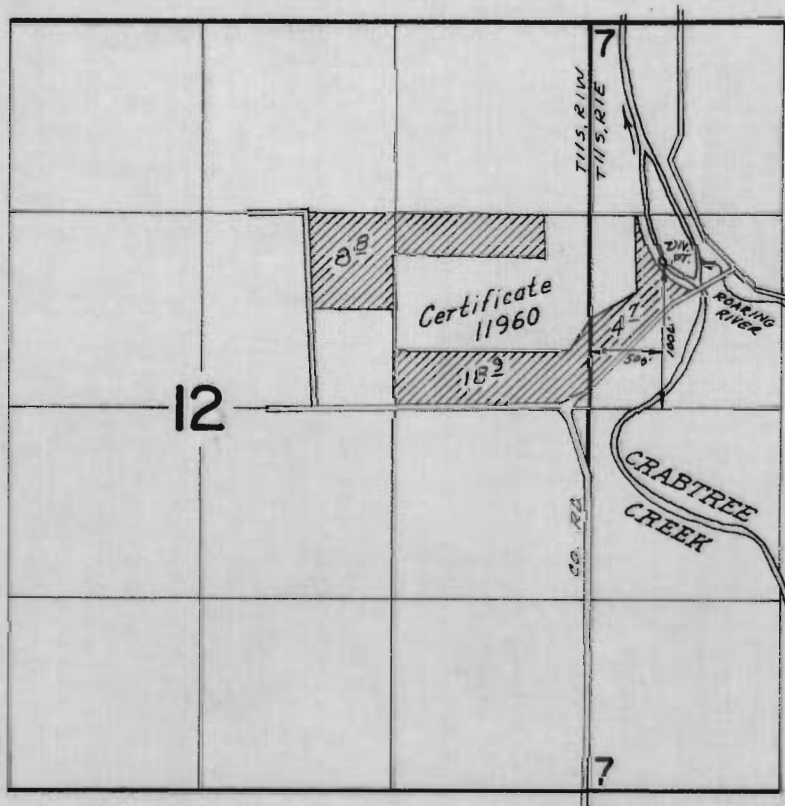

## FINAL PROOF SURVEY UNDER

Application No. 49481 Permit No. 37063  
IN NAME OF

JOHN deJONG

Surveyed May 20 1974, by D.M. Norby