


T.7S., R.2W., W.M.

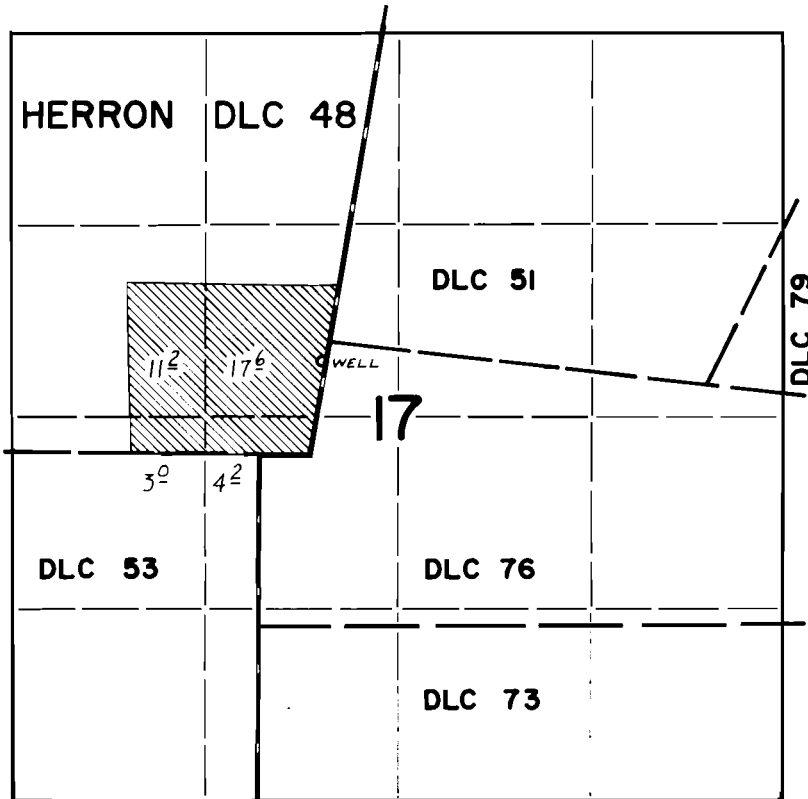

WELL LOC: 650' N & 80' E FROM SE COR. HERRON DLC 48

FINAL PROOF SURVEY UNDER

Application No. G-4455 Permit No. G-4198
IN NAME OF

FRITZ WEGSCHEIDER

Surveyed Aug. 12, 1975, by D. Norby