


T.5S. R. 2W. W.M.

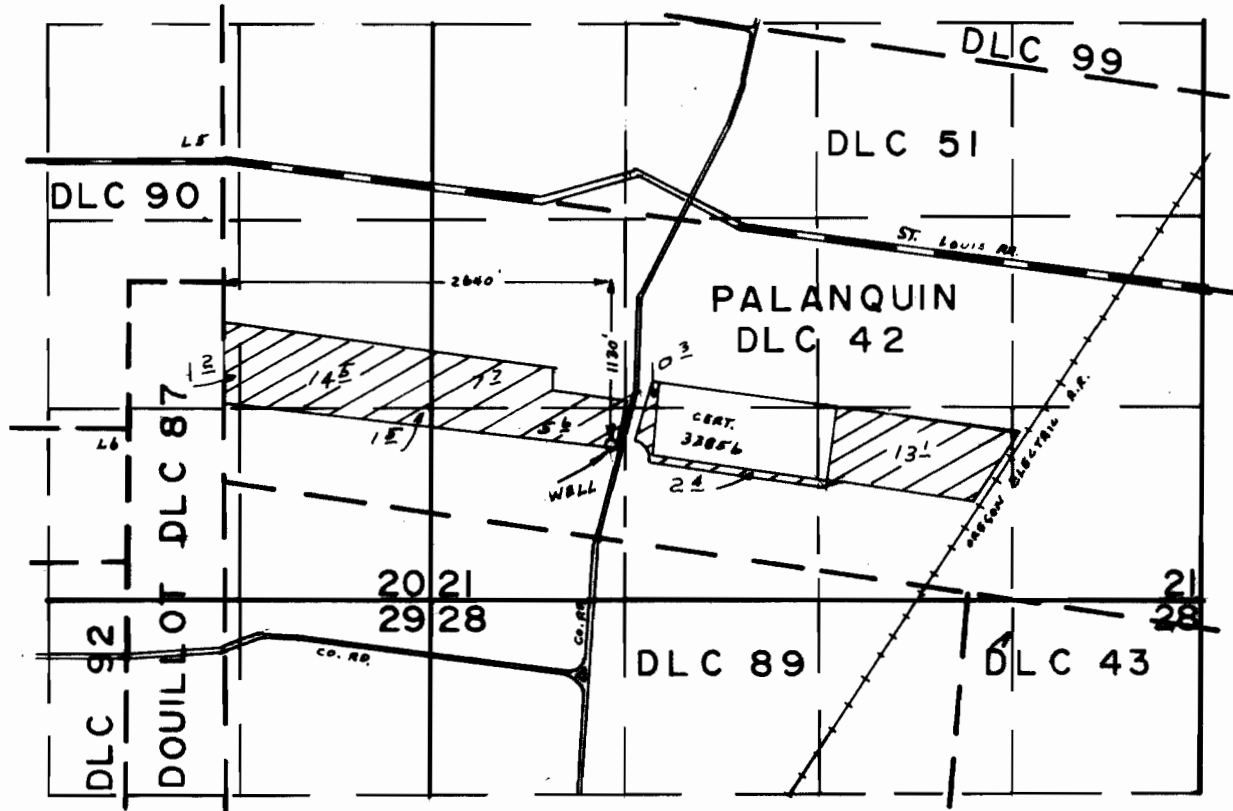

FINAL PROOF SURVEY
UNDER

Application No. G-5539. Permit No. G-4996
IN NAME OF

HARRY LAMBERT

Surveyed SEP. 3. 1974, by L.H. NUNN