


T.7S.R.2E.W.M.

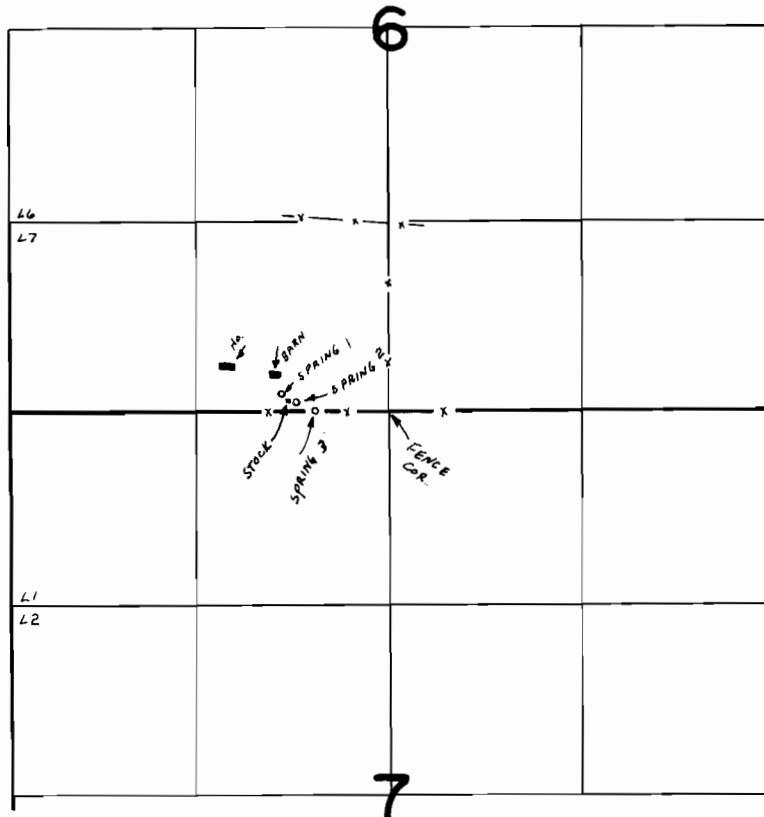

SPRINGS LOC. 1- 110' N. & 730' W., 2- 60' N. & 630' W.,
3- 510' W. ALL FROM S 1/4 COR. SEC. 6

FINAL PROOF SURVEY
UNDER

Application No. 44924 Permit No. 33576...
IN NAME OF

G. PLAS

Surveyed MAY 28 1974, by L.H. NUNN.....