


# T. 7 S., R. 6 W., W.M.

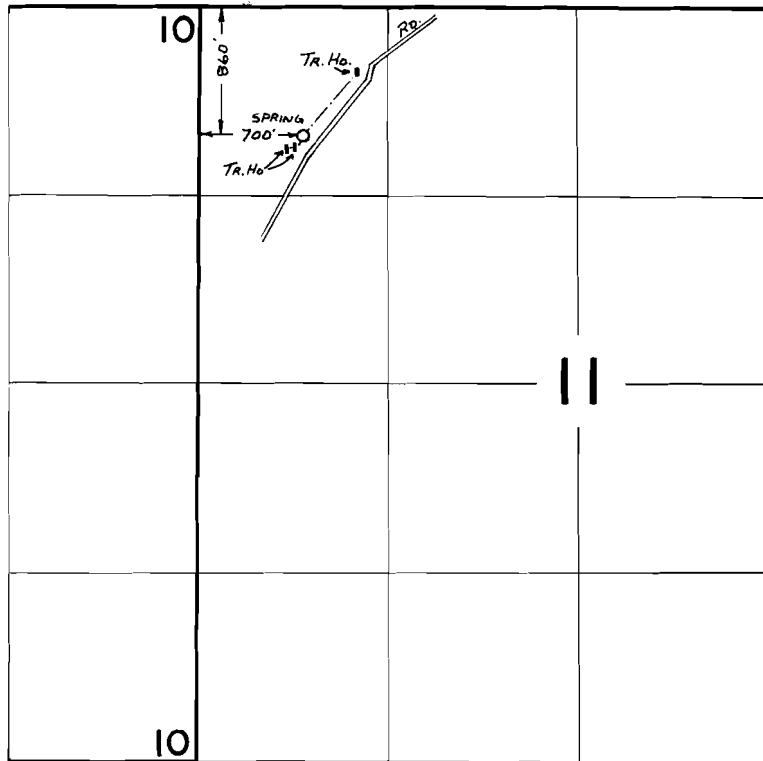

## FINAL PROOF SURVEY UNDER

Application No. **45029** Permit No. **33123**  
IN NAME OF

**GEORGE H. WRIGHT**

Surveyed July 19 1974, by **L. H. NUNN**