


# T.1S.R.8W.W.M.

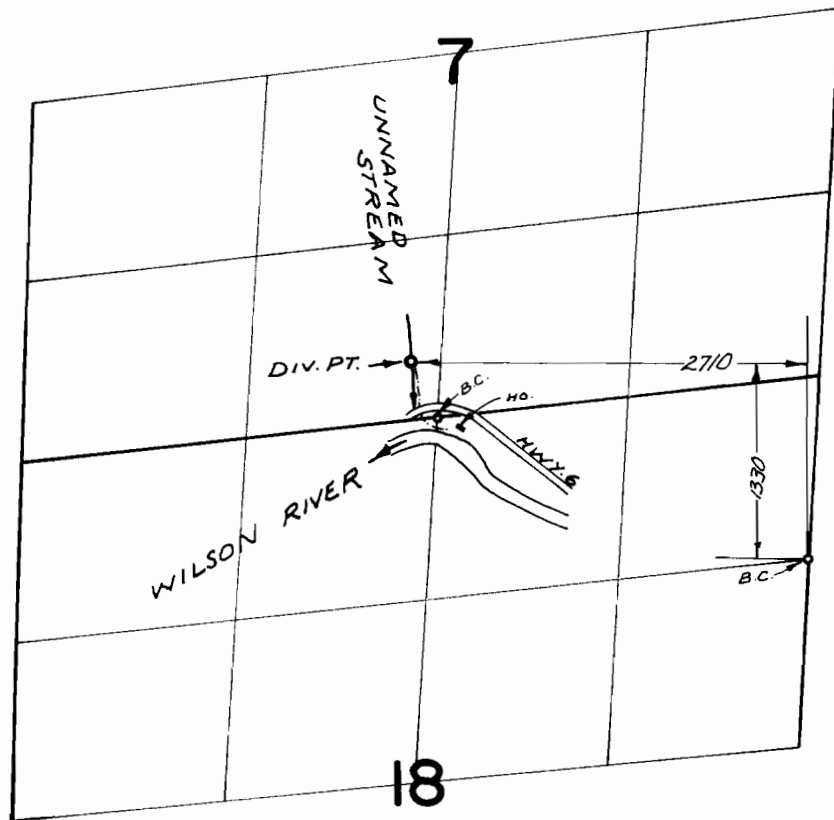

## FINAL PROOF SURVEY UNDER

Application No. 34693 Permit No. 27213  
IN NAME OF

DAVID W. & THELMA WILLIAMS

Surveyed JULY 19, 1963, by R. JACKSON  
JUNE 11, 1971 L. E. GOULD  
SEPT. 12, 1974 R. MUCKEN