


T. 3 S., R. 10 W., W.M.

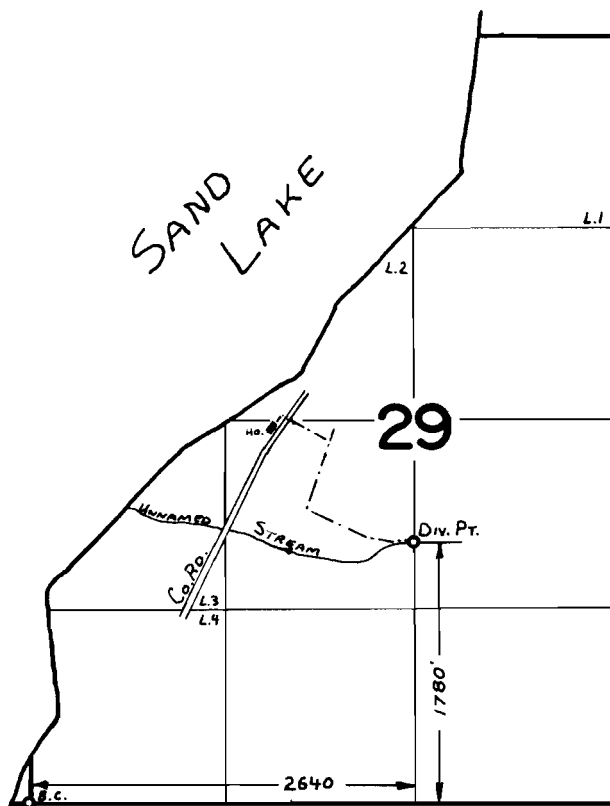

FINAL PROOF SURVEY
UNDER

Application No. 45200... Permit No. 33767...
IN NAME OF

FRANK C. EGANS

Surveyed Aug. 29 1974, by L. TOLL