


T. 4 S., R. 9 W., W.M.

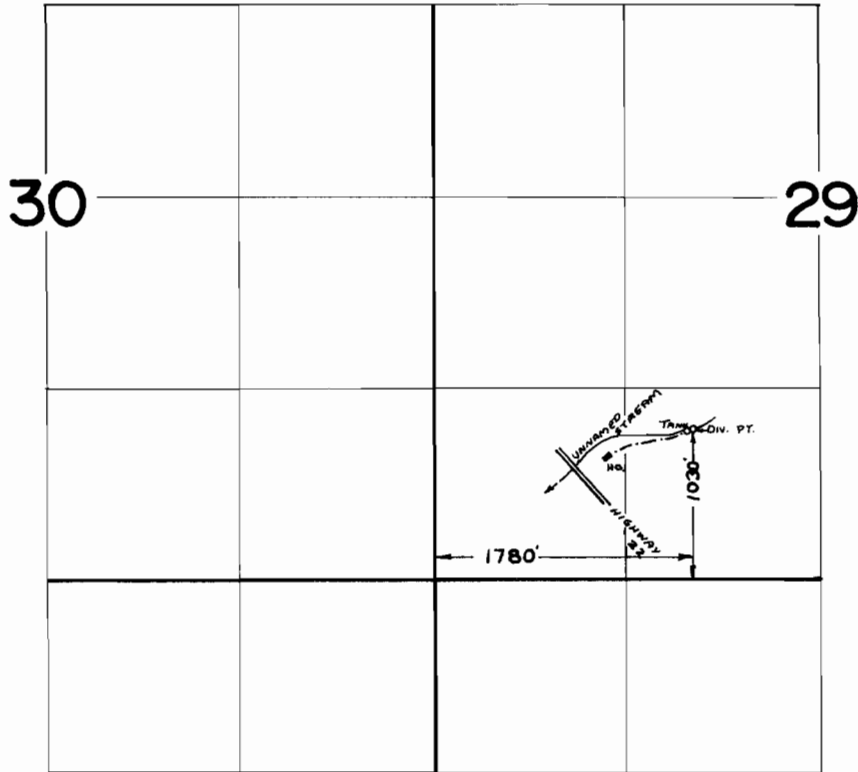

FINAL PROOF SURVEY
UNDER

Application No. 46877 Permit No. 35046
IN NAME OF

..... E. J. SARGENT

Surveyed JUNE 26 1974, by L. TOLL.....