


T. 5 S., R. 10 W., W.M.

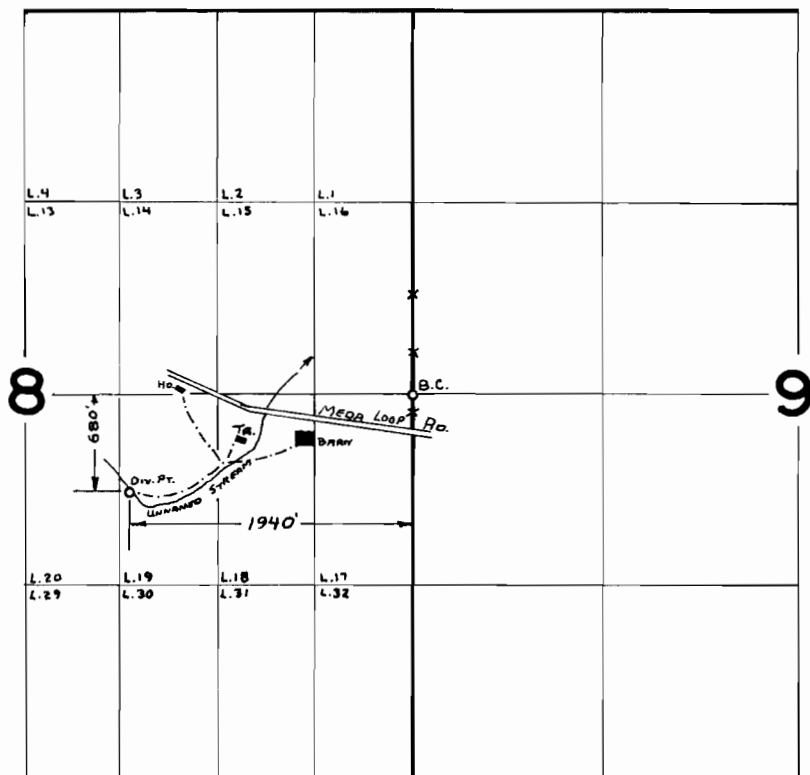

FINAL PROOF SURVEY

UNDER

Application No. **46992** Permit No. **35159**.....
IN NAME OF

JACK, JOHN E., & WILMA D. HAGERTY.

Surveyed Aug. 27, 1974, by L. Toll.....