


T. 1&2 S., R. 8 W., W.M.

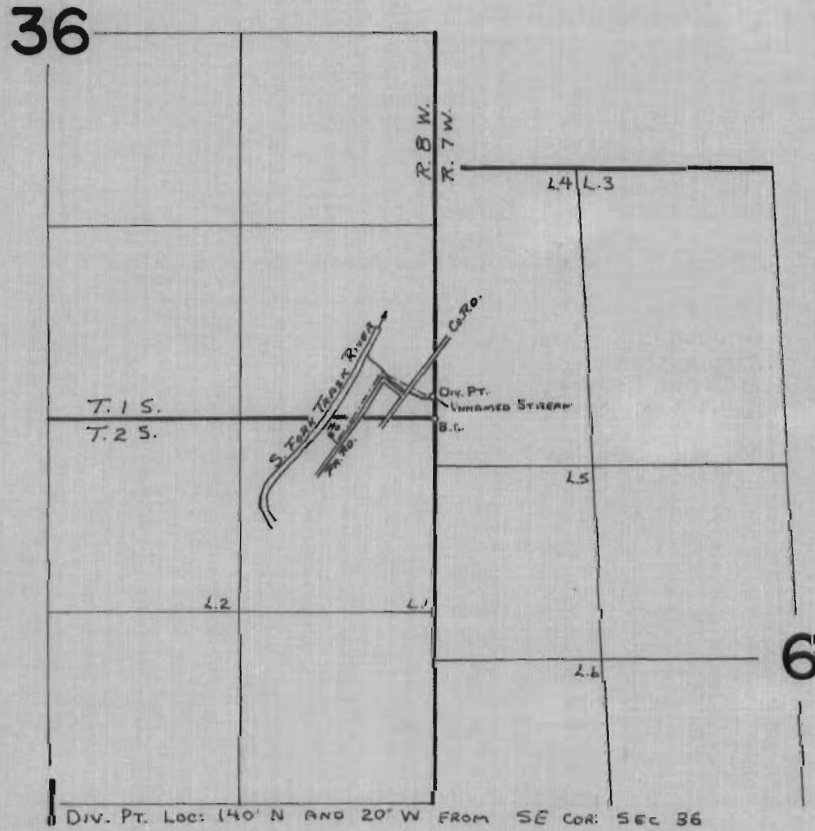

FINAL PROOF SURVEY
UNDER

Application No. 47665 Permit No. 35665
IN NAME OF

DONALD L. & PATRICIA A. KEHR

Surveyed JUNE 25 1974, by L. TOLL