


T. 1 & 2 S., R. 8 W., W.M.

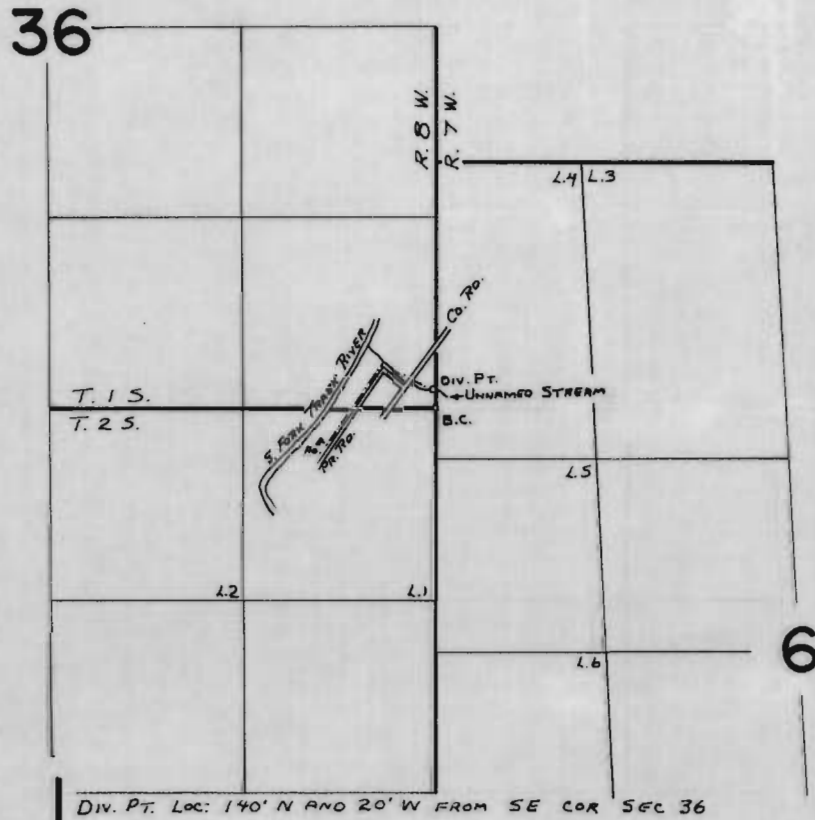

FINAL PROOF SURVEY
UNDER

Application No. 47874... Permit No. 35875...
IN NAME OF

WILLIAM J. & G. JEANNE WEHINGER

Surveyed JUNE 24 1974, by L. TOLL.....