


# T.1N.,R.9W.,W.M.

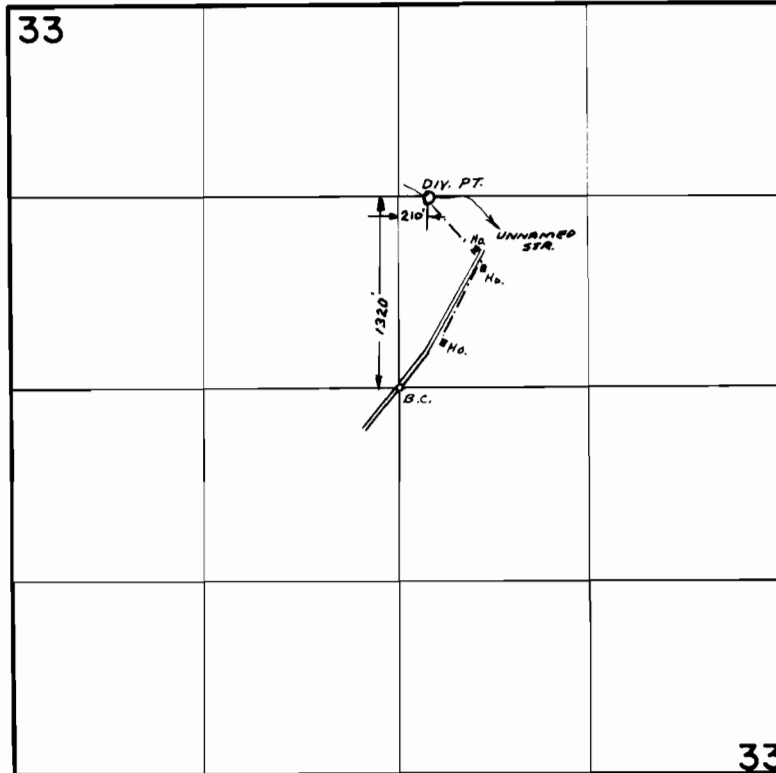

## FINAL PROOF SURVEY UNDER

Application No. **47986** Permit No. **35993**  
IN NAME OF

**MARGARET L. PARKER**

Surveyed **JUNE 26 1974**, by **D. NORBY**