


T.4S.,R.10W.,W.M.

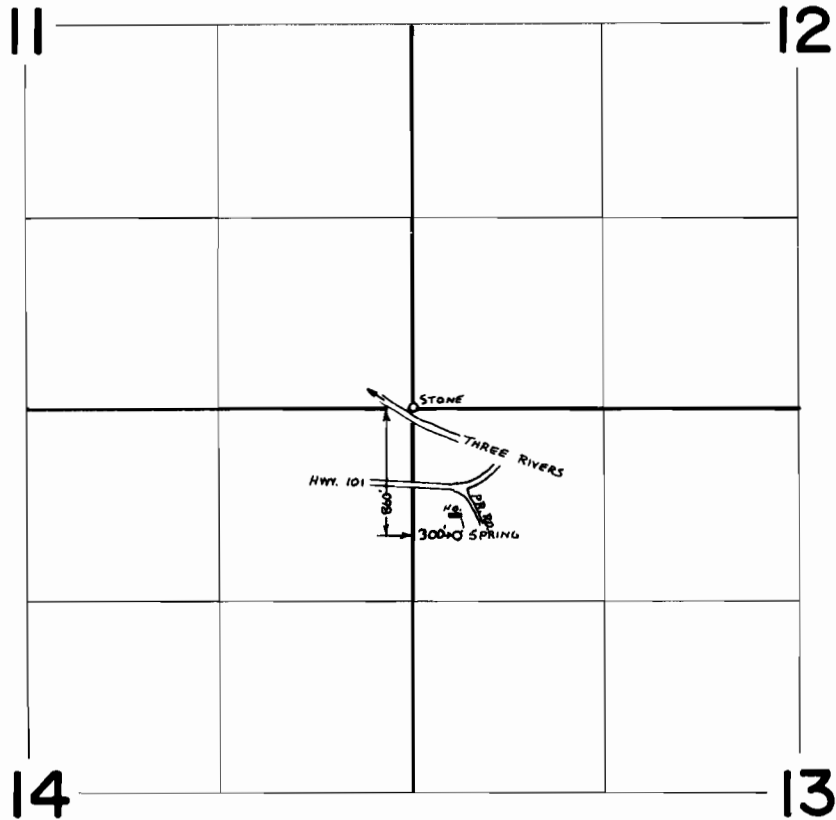

FINAL PROOF SURVEY
UNDER

Application No. 49784 Permit No. 36100
IN NAME OF

HELEN A. AFFOLTER

Surveyed JUNE 26 1974, by L. TOLL