



T. 1 S. R. 2 W. W. M.

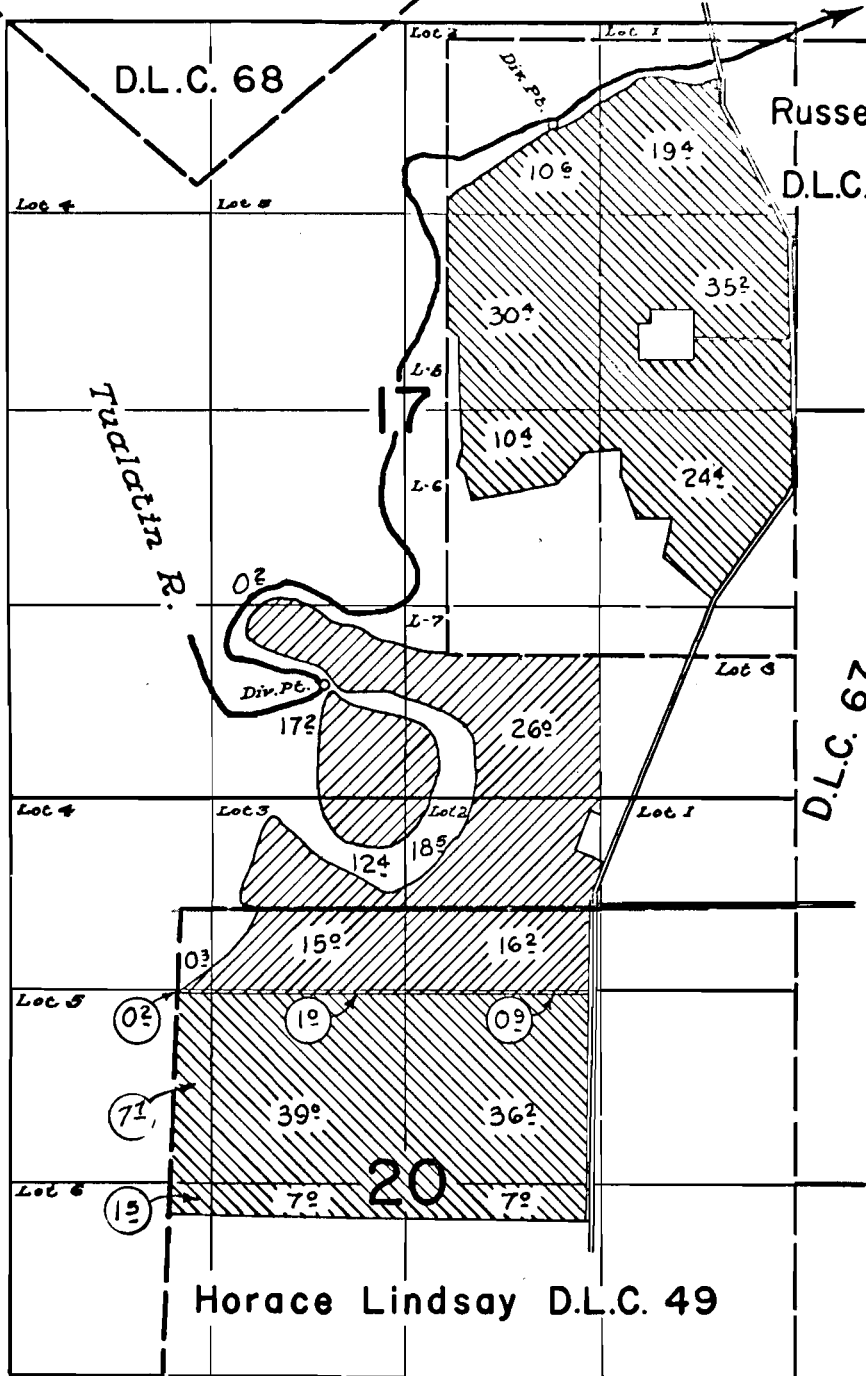

FINAL PROOF SURVEY
UNDER

R. 43511
 43512
 28804
 Application No. 32902... Permit No. 26060 

R. 5022
 32670
 22669

IN NAME OF

EDWARD H. FREUDENTHAL

Surveyed June 21, 1960, by *Appelton*