


T.4S. R.7W. W.M.

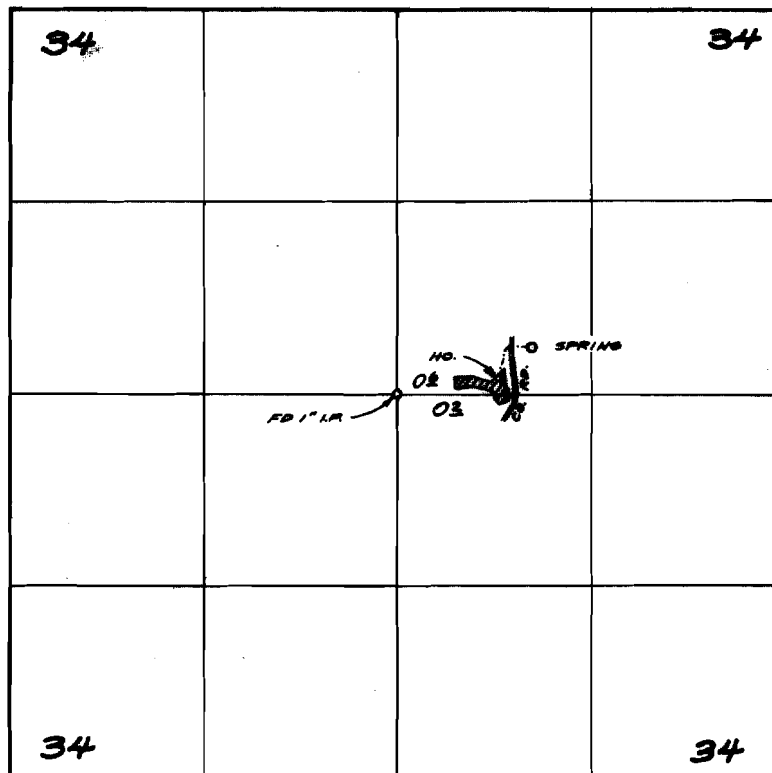

SPRING LOCATED: 320' N, 920' E, FROM CENTER SECTION 34

**FINAL PROOF SURVEY**  
UNDER

Application No. 44170 Permit No. 32977  
IN NAME OF

DONALD WILLIAM DAVIS

Surveyed JULY 26 1974, by L.M. TOLL