


# T. 5S. R. 1W. W.M.

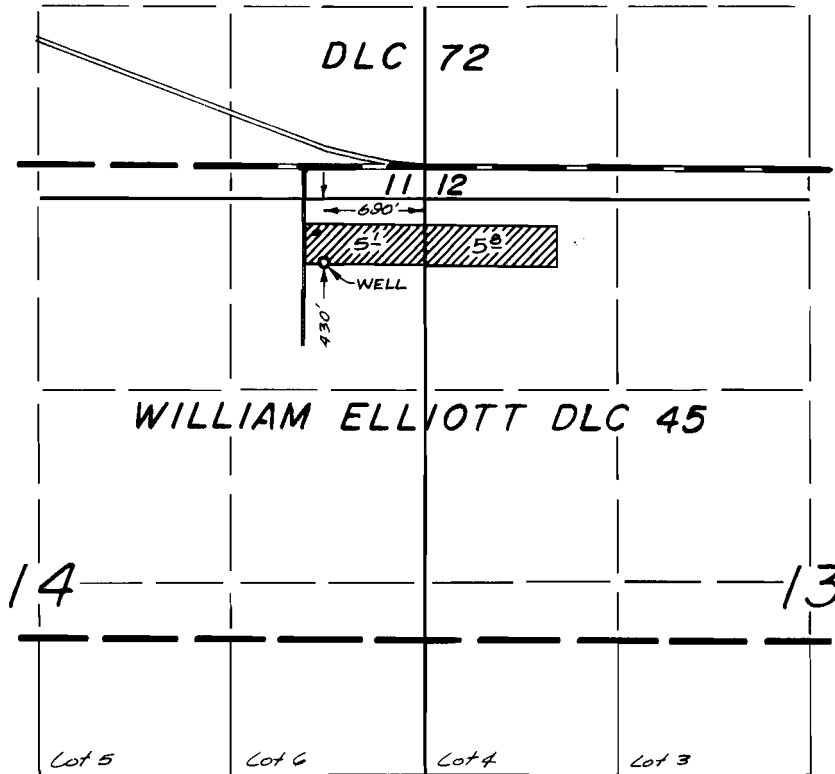

## FINAL PROOF SURVEY UNDER

Application No. 05338 Permit No. 64987  
IN NAME OF

ANDREY KAYA

Surveyed SEPT. 5 1975, by R.G. MUCKEN