


T.2S. R.1E. W.M.

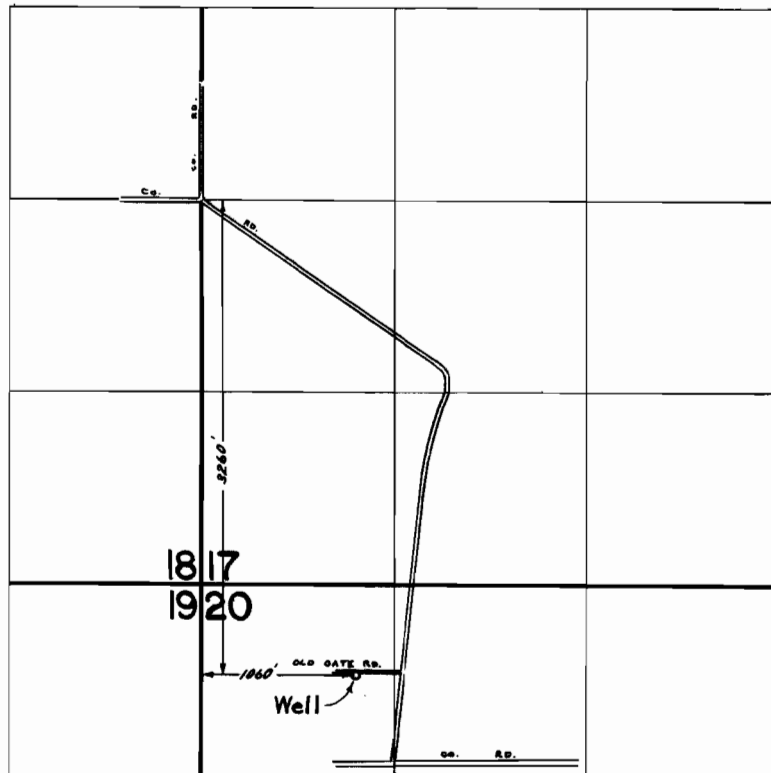

FINAL PROOF SURVEY
UNDER

Application No. G-1349 Permit No. G-1196
IN NAME OF

RIVERGROVE WATER DISTRICT

Surveyed SEPT. 30, 1974, by L. E. GOULD