


T.5 S. R.1 E. W.M.

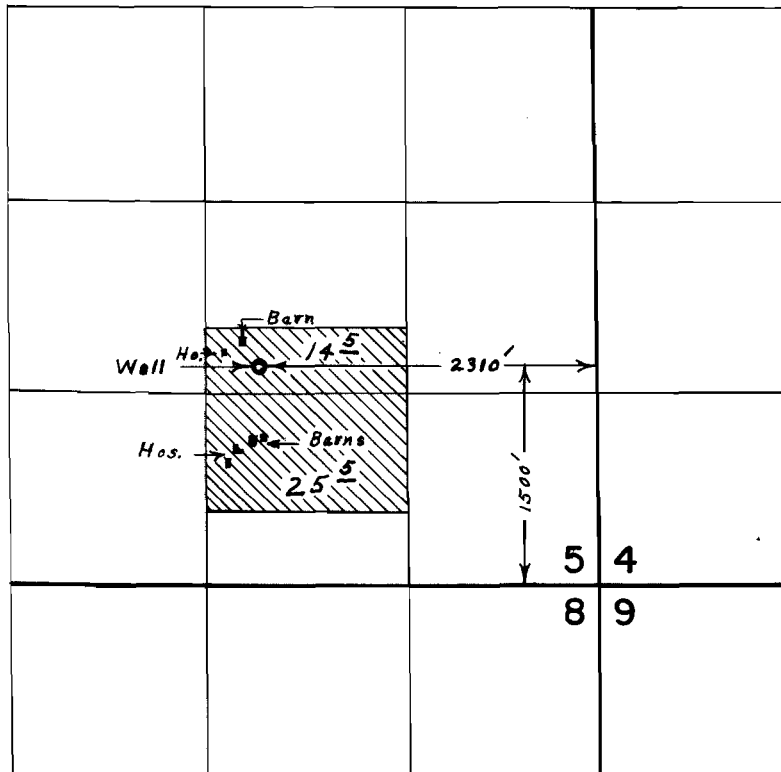

**FINAL PROOF SURVEY**  
UNDER

Application No. G-5575 Permit No. G-5030  
IN NAME OF

**LAWRENCE A. & SHARON GAY WRIGHT**

Surveyed June 19, 1974, by L. E. Gould