


T.2S. R.5E. W.M.

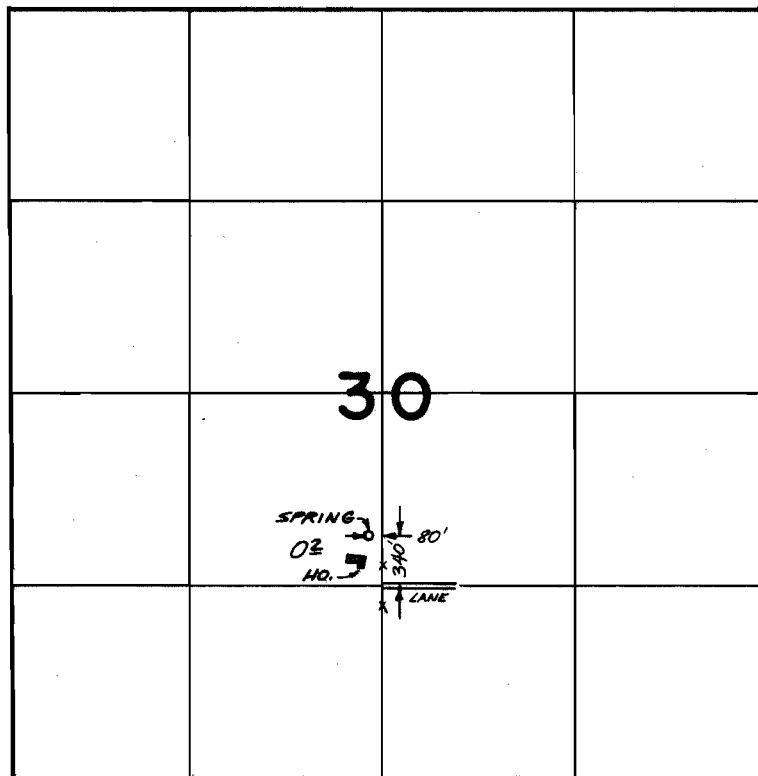

FINAL PROOF SURVEY
UNDER

Application No. 46962 Permit No. 35138
IN NAME OF

GEORGE H. PLASTER Jr.

Surveyed SEPT. 24 1975, by R.G. MUCKEN