


T. 3 S. R. 1 E. W. M.

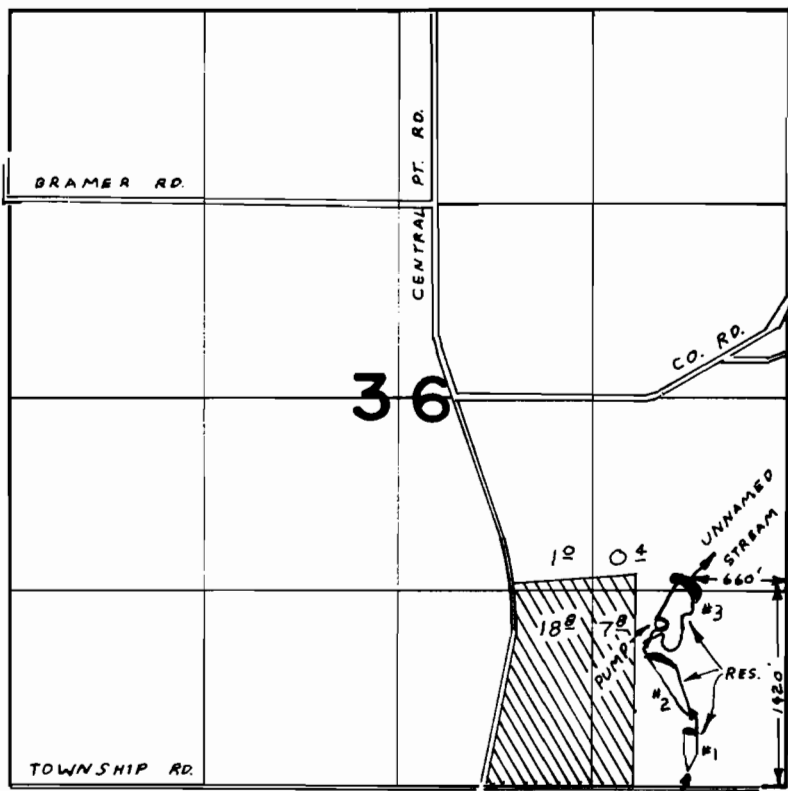

FINAL PROOF SURVEY
UNDER

R-48148

R-5754

Application No. 48149 Permit No. 35710
IN NAME OF

SKYLANE FARMS

Surveyed NOV. 7 1974, by LH NUNN