


T. 6 S. R. 2 E. W. M.

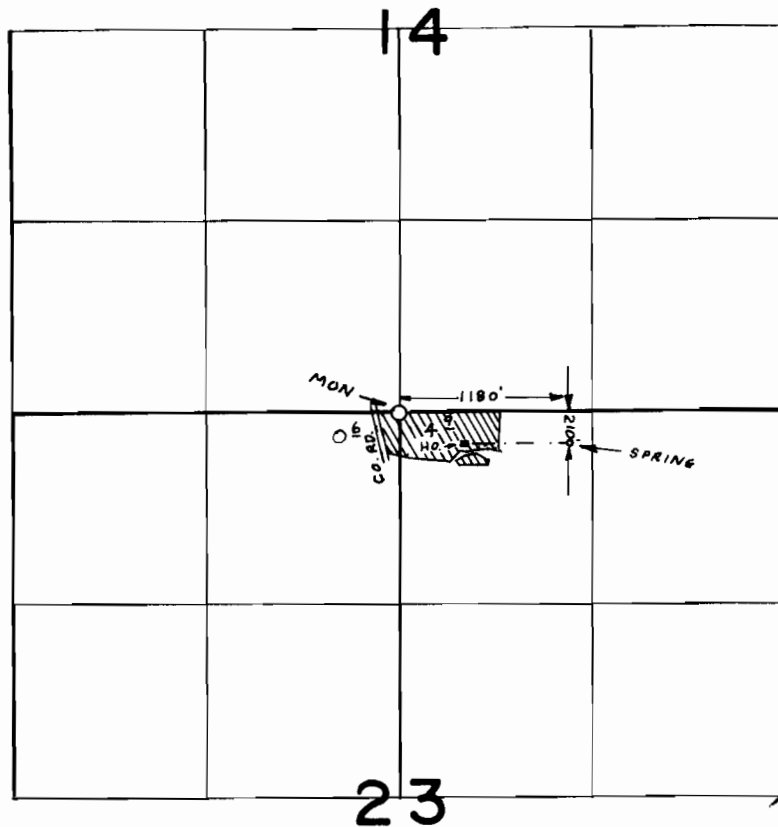

FINAL PROOF SURVEY
UNDER

Application No. 49245 Permit No. 36908
IN NAME OF

ROBERT R. AND ANN GRIPP

Surveyed SEP 27 1974, by LH NUNN