


T. 39S. R. 14W. W.M.

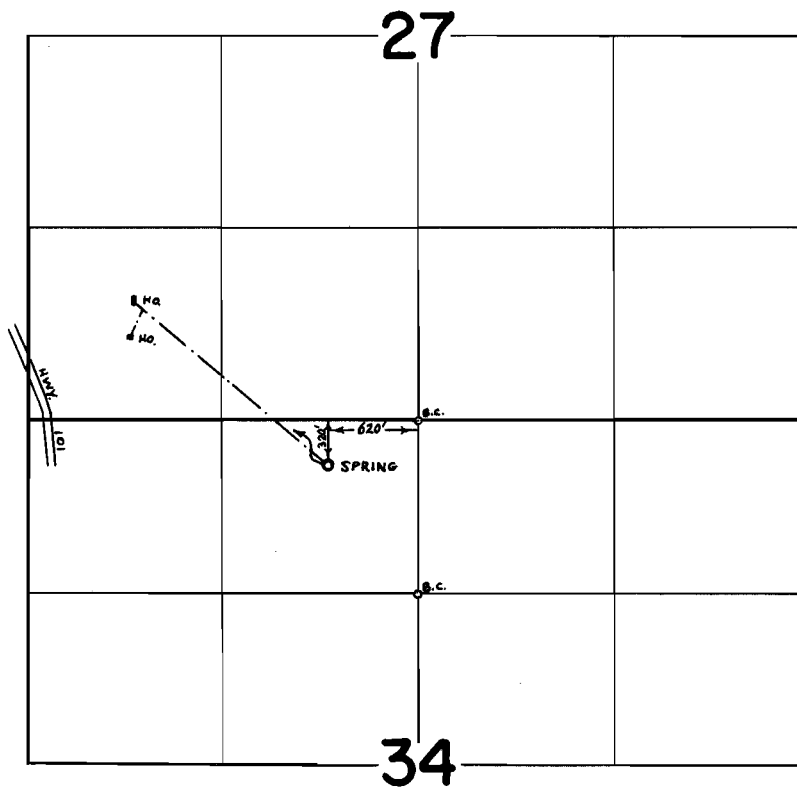

FINAL PROOF SURVEY
UNDER

Application No. 48220 Permit No. 36212
IN NAME OF

JOEL V. & SEVILLA R. BERREMAN

Surveyed JULY 22 1975, by L. TOLL