


T.28S.,R.7W.,W.M.

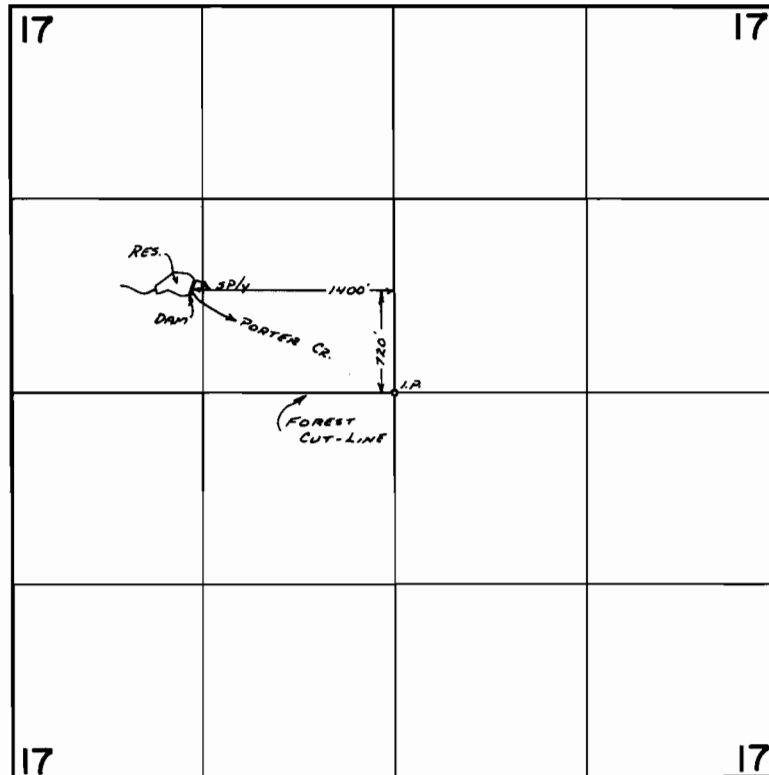

FINAL PROOF SURVEY
UNDER

R-44698 R-5244
Application No. 44919 Permit No. 33216
IN NAME OF

GERHARDT W. RIEDEL

Surveyed July 22 1975, by L. E. Gouge