


T.28S.,R.7W.,W.M.

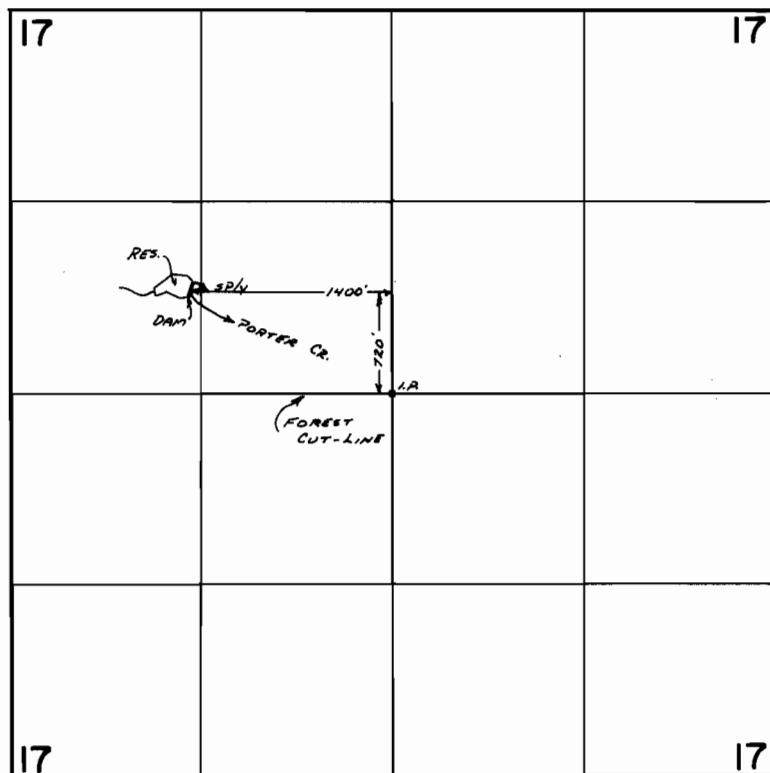

FINAL PROOF SURVEY
UNDER

Application No. R-44698 44919 Permit No. R-5244 33216
IN NAME OF

GERHARDT W. RIEDEL

Surveyed JULY 22 1975, by L. E. Gault