


T.38S. R.1W. W.M.

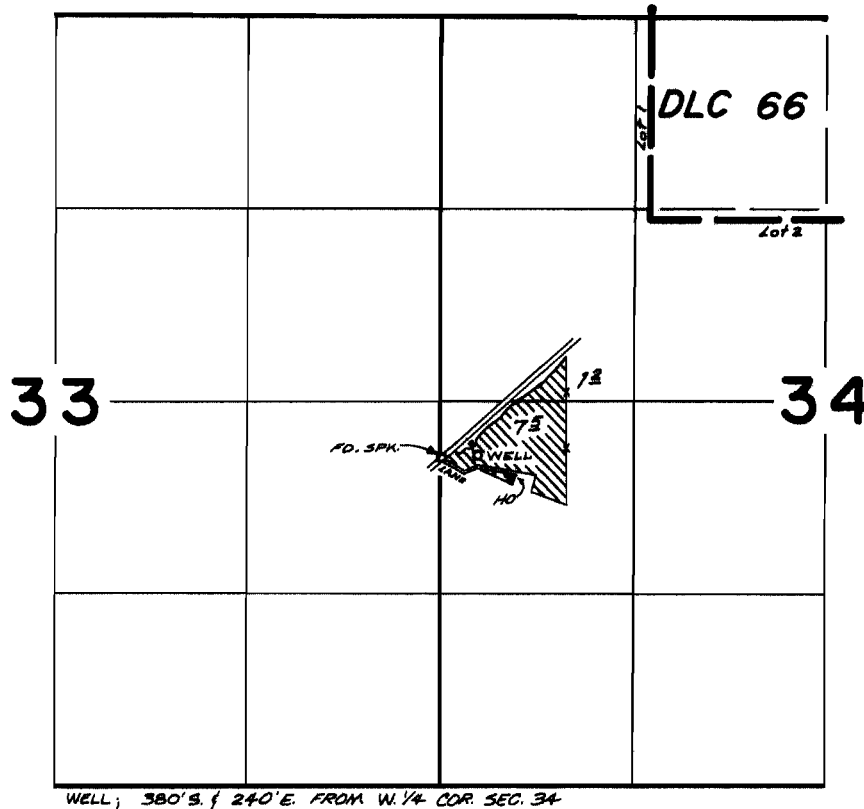

FINAL PROOF SURVEY UNDER

Application No. G4996 Permit No. G4714
IN NAME OF

B. KEITH & PATRICIA A. HARLOW

Surveyed JULY 16, 1974, by R.G. MUCKEN