


T.34S., R.2W., W.M.

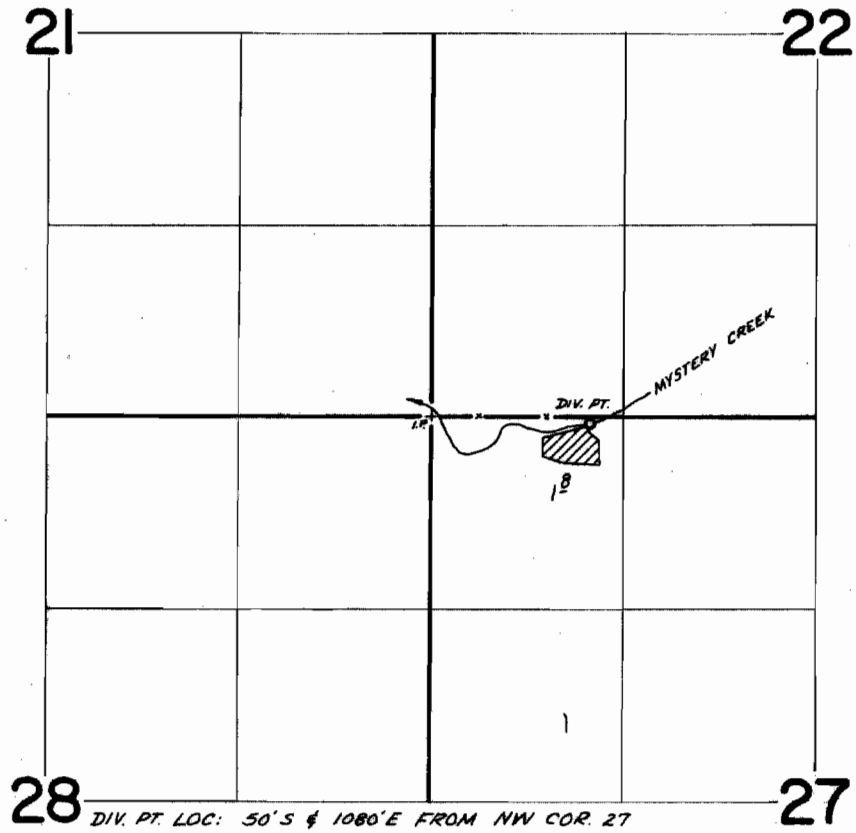

**FINAL PROOF SURVEY**  
UNDER

Application No. 47124 Permit No. 35286

IN NAME OF

CLIFFORD C. AND HELEN M. JOSEY

Surveyed Aug. 25 1975, by D. Norby