


T.36S.,R.3W.,W.M.

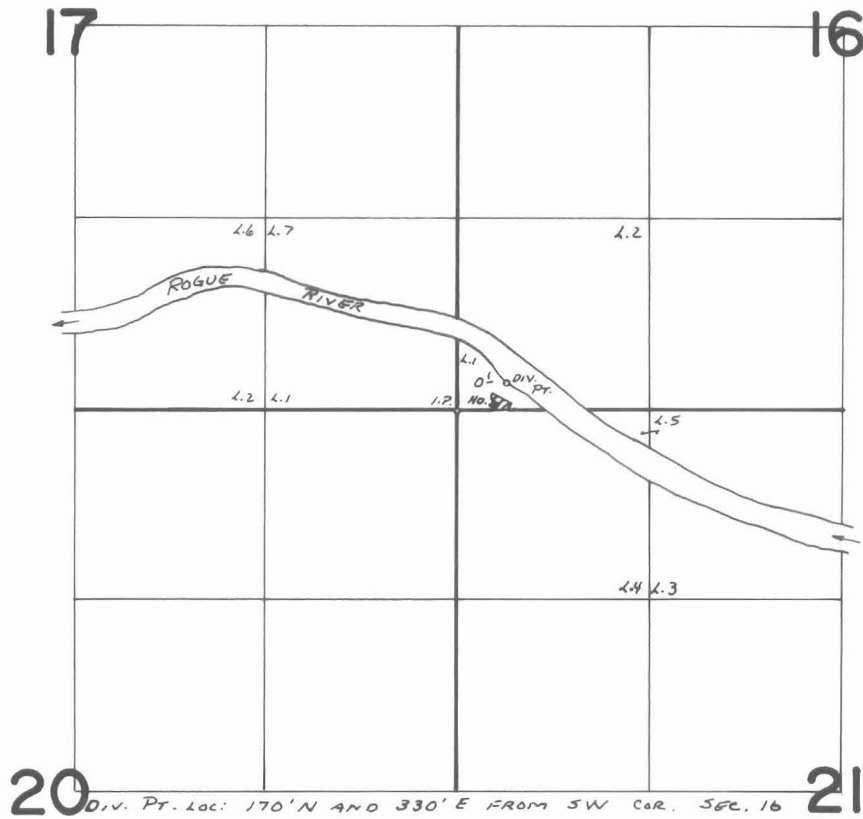

FINAL PROOF SURVEY
UNDER

Application No. 49520 Permit No. 37365
IN NAME OF

WILLIAM H. & RUTH G. STEINMETZ

Surveyed AUG. 13, 1975, by L. E. GOULD