


T. 16 S. R. 5 E. W. M.

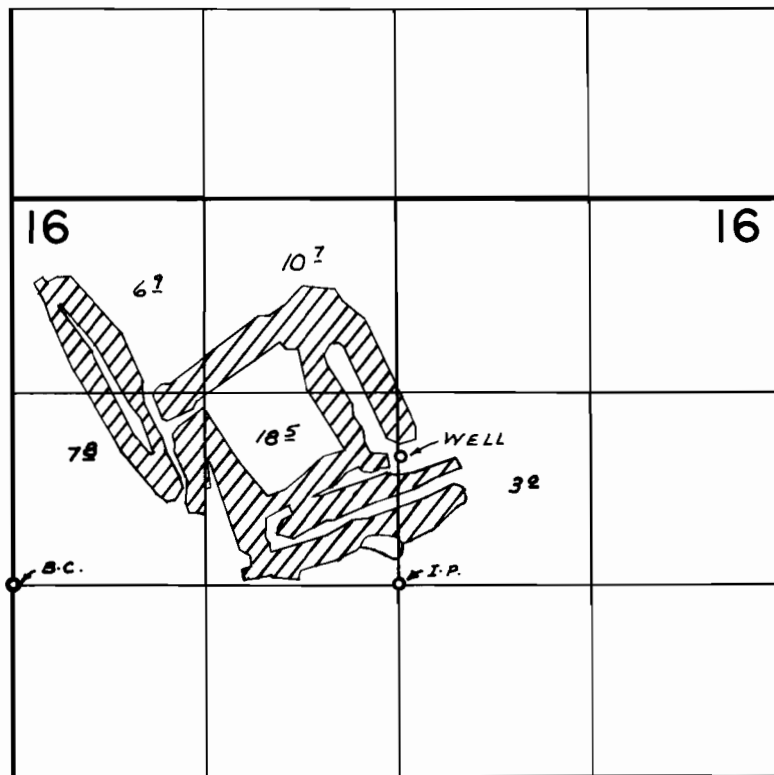

WELL LOC: 870' N. & 20' E. FROM CENTER SEC. 16

FINAL PROOF SURVEY
UNDER

Application No. G-3239 Permit No. G-3001
IN NAME OF

N. B. GIUSTINA

Surveyed JUNE 14, 1967, by V. GARNER
AUG. 21, 1974 L. NUNN
AUG. 17, 1977 L. M. TOLL