


T.18S.,R.6W.,W.M.

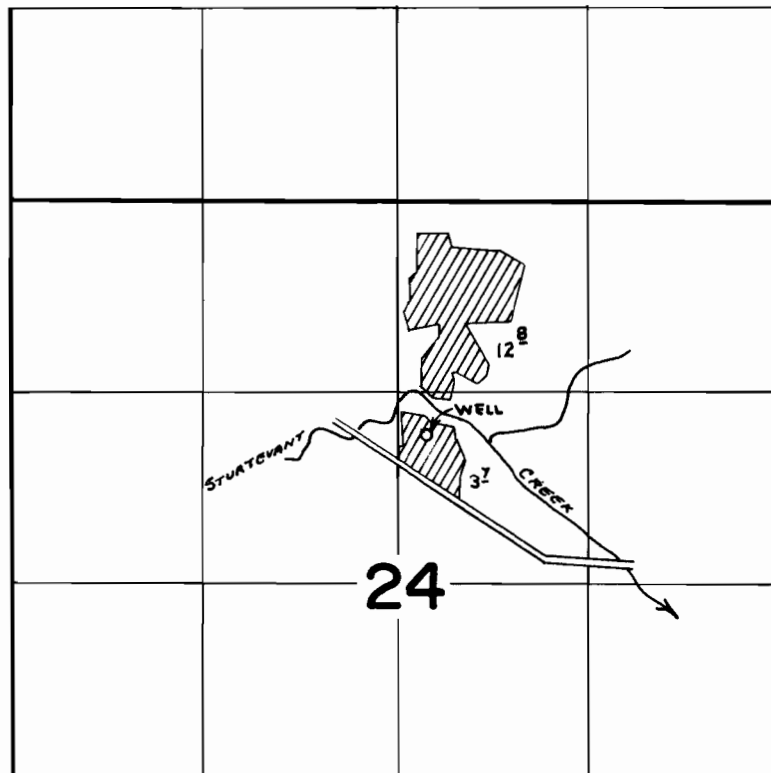

WELL Loc: 1600'S AND 200'E FROM N¹/₄ COR. SEC. 24

FINAL PROOF SURVEY
UNDER

Application No. G-3778 Permit No. G-3563
IN NAME OF

G. W. SCHAREN

Surveyed OCT. 29 1974, by L. H. NUNN