


T.15S.R.4W.W.M.

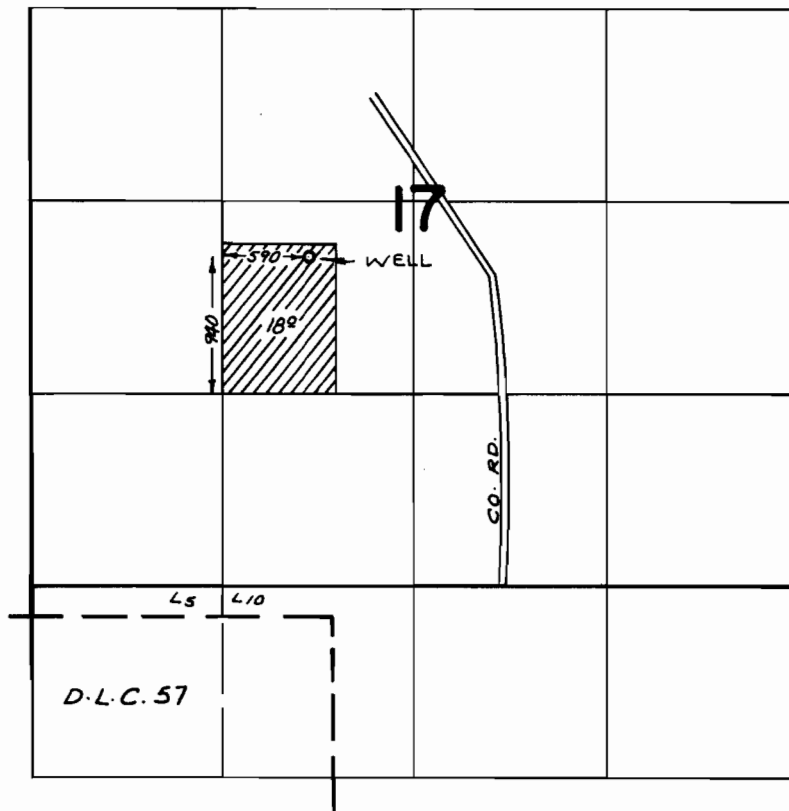

FINAL PROOF SURVEY UNDER

Application No. G-4638 Permit No. G-4362
IN NAME OF

AUDREY FARVER

Surveyed MAY 31, 1974, by R. MUCKEN