


T.15S.R.4W.W.M.

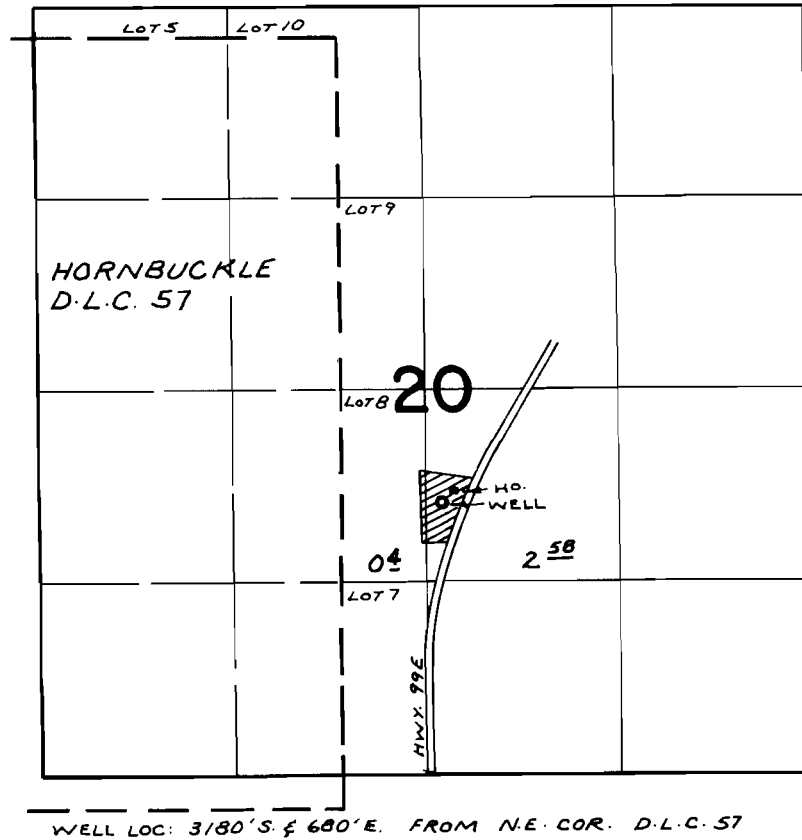

FINAL PROOF SURVEY UNDER

Application No. *G-5207*. Permit No. *G-5072*
IN NAME OF

.....*L. JOHN LAIS*.....

Surveyed *MAY 28 1974*, by *R. MUCKEN*