


T.16S.R.4W.W.M.

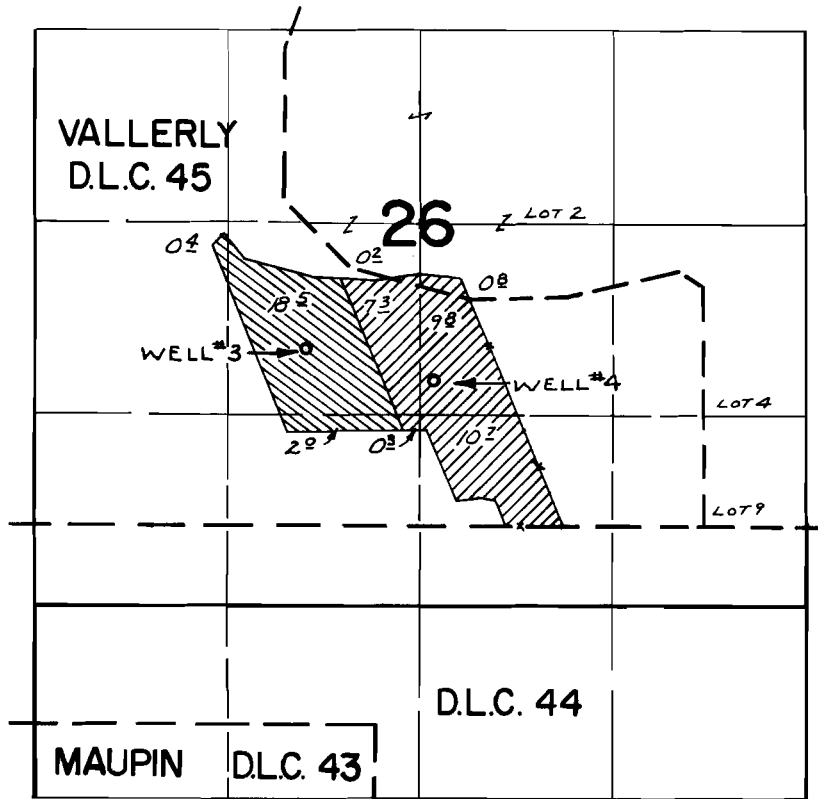

WELLS LOC: #3 - 2580' N. & 490' W; #4 - 2370' N & 390' E; BOTH FROM N.E. COR. D.L.C. 43

FINAL PROOF SURVEY UNDER

Application No. G-5211 Permit No. G-5075
G-5212 G-5076
 IN NAME OF

CLARENCE BOND

Surveyed MAY 31, 1974, by R. MUCKEN