


T.16&17S. R.3W. W.M.

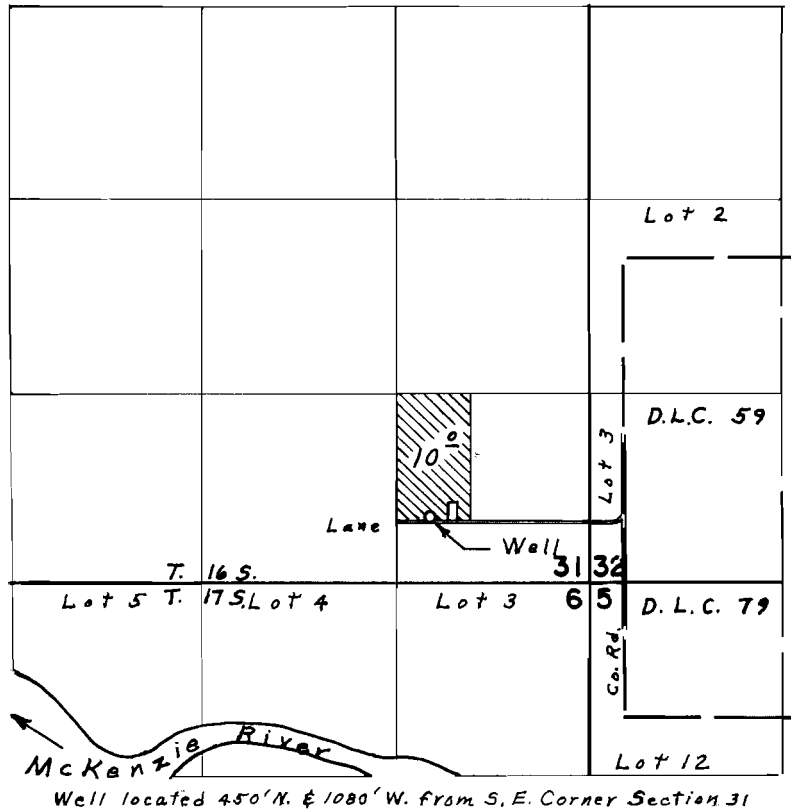

FINAL PROOF SURVEY
UNDER

Application No. G-5288 Permit No. G-5125
IN NAME OF

MILDRED E. STORMENT

Surveyed July 22, 1974, by L. E. Gould